


No 292

89 1st gr 19

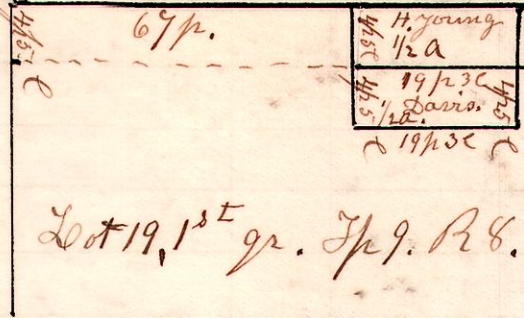

A Survey made for John Davis to locate lines
 & corners of aces in Lot 19, first quarter,
 Township 9 of Range 8,
 October 16th 1899.


H. H. Robinson
 Deft. & Surveyor

13 13 3

*Stone

JACKSON ST.

No. 293.

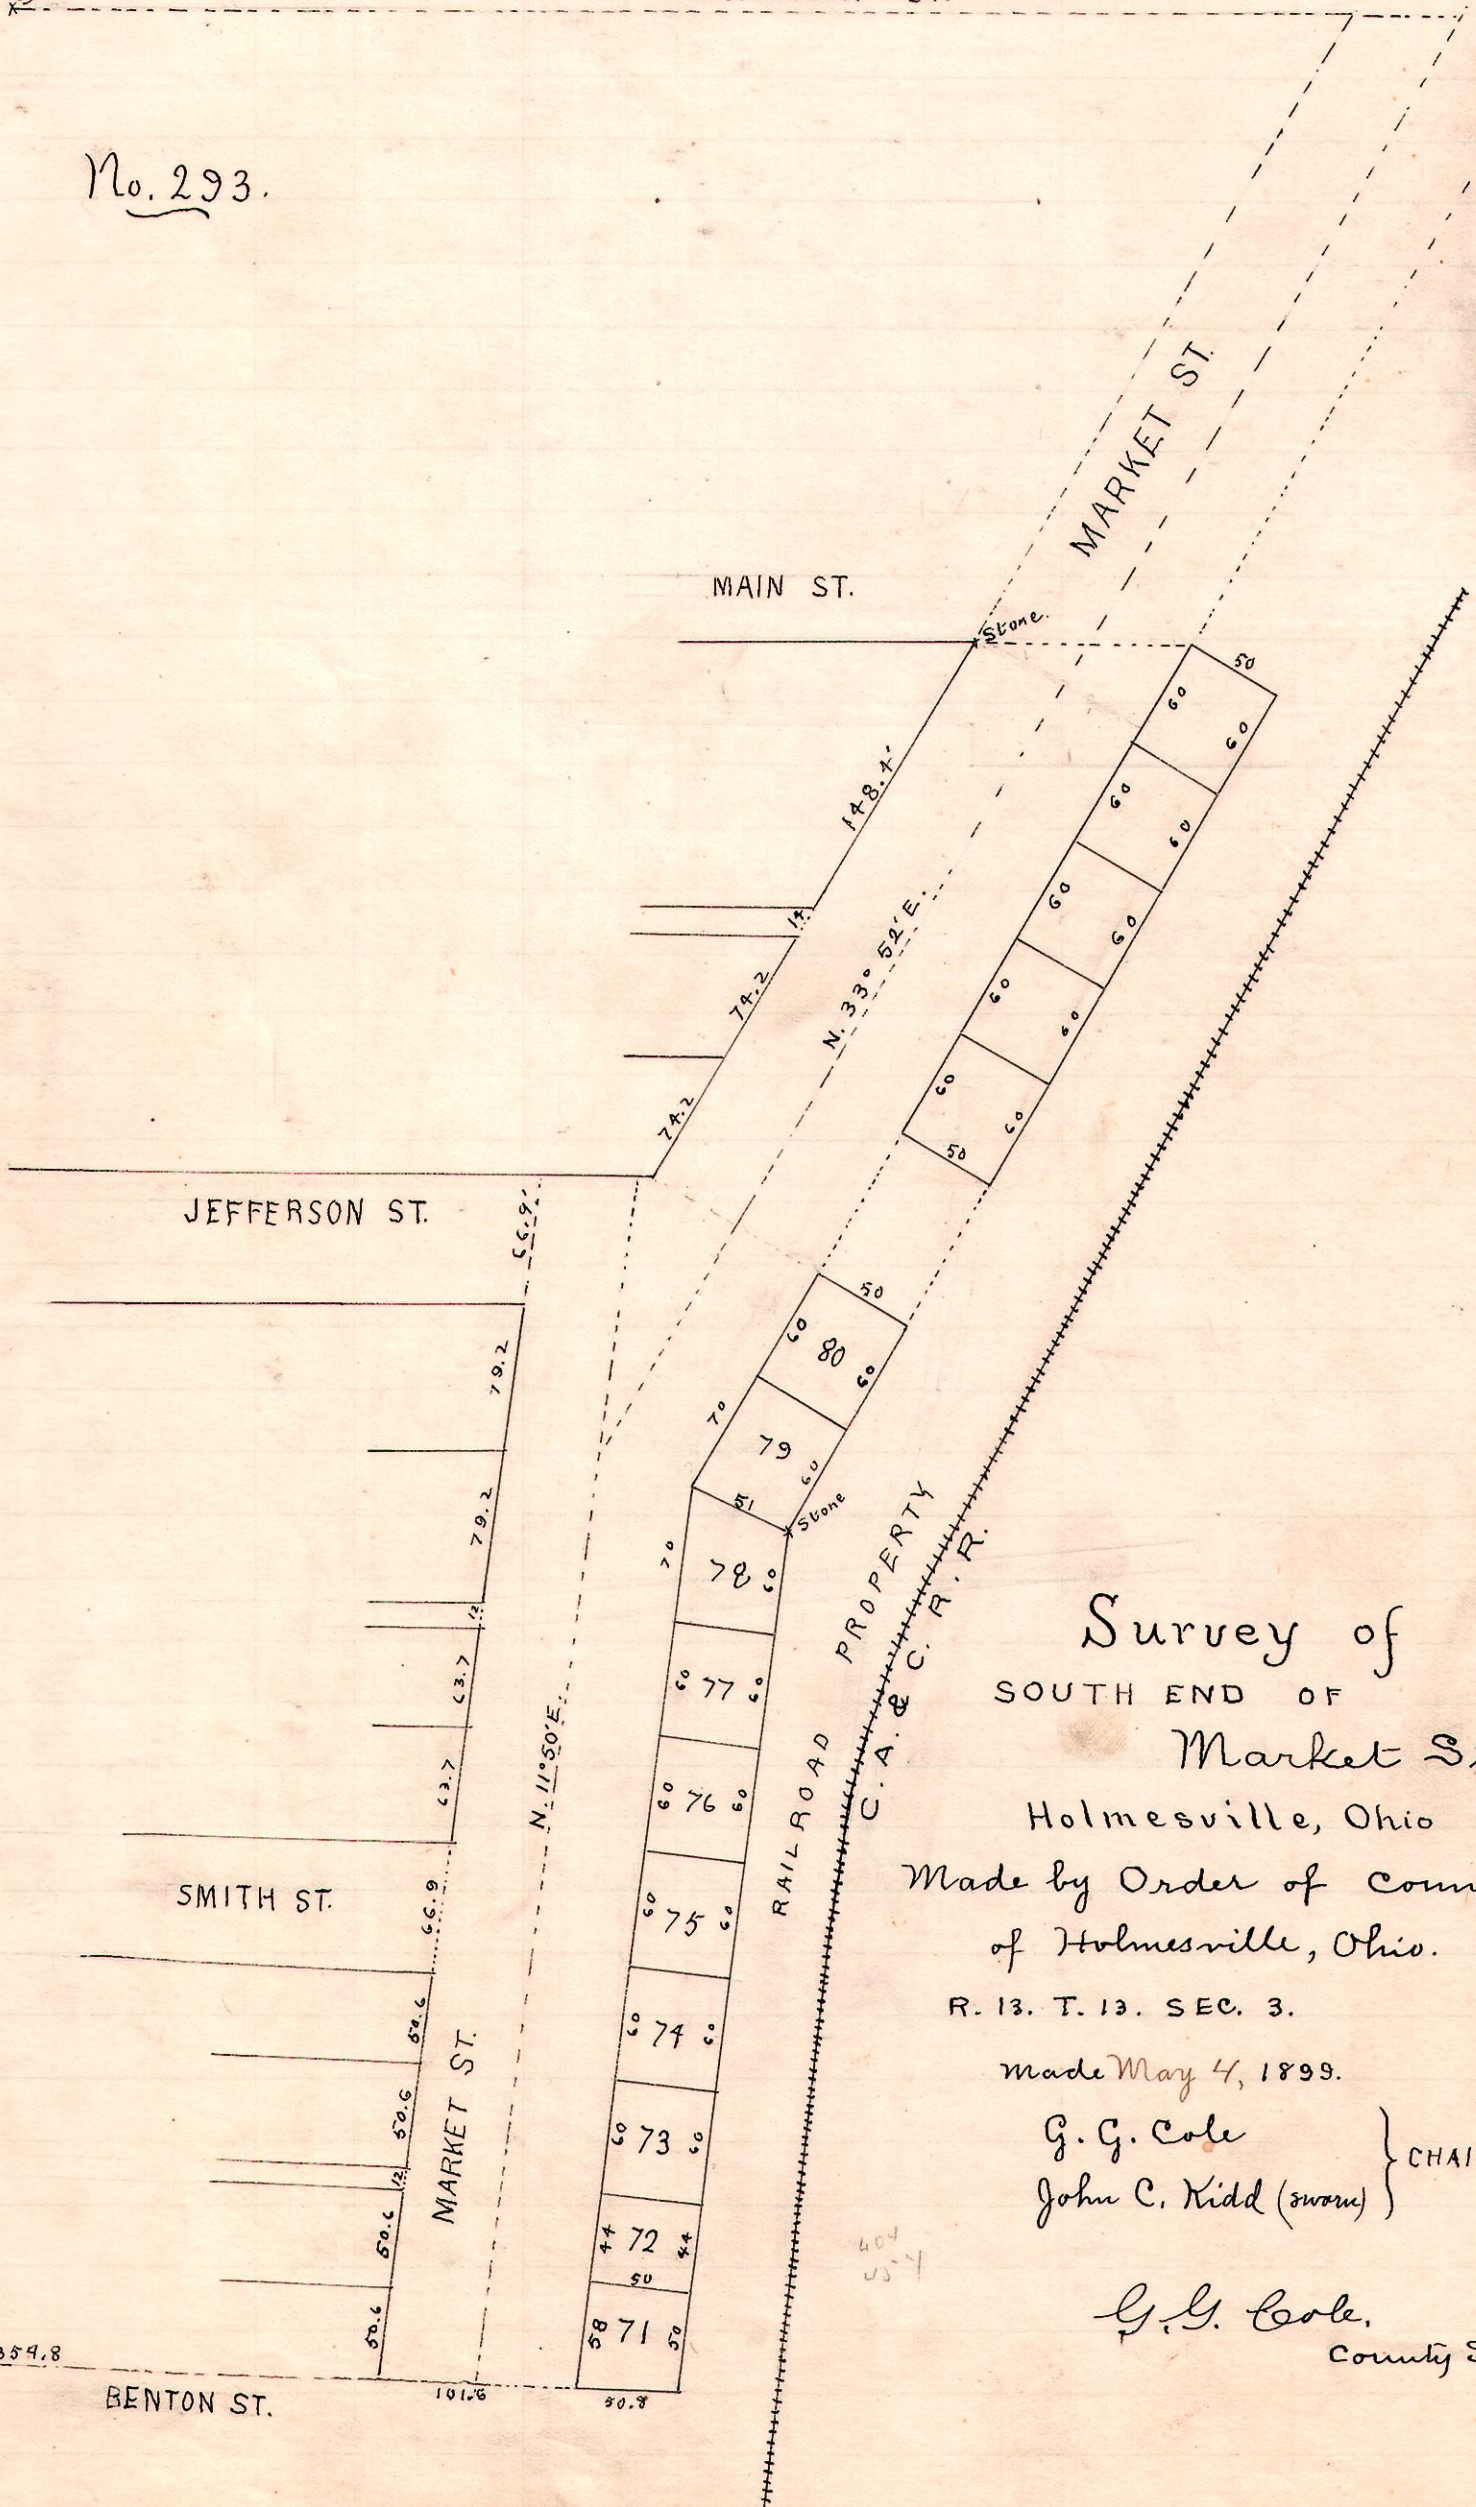

Survey of
 SOUTH END OF
 Market St.,
 Holmesville, Ohio
 Made by Order of Council
 of Holmesville, Ohio.
 R. 13. T. 13. SEC. 3.

Made May 4, 1899.

G. G. Cole }
 John C. Kidd (sworn) } CHAINMEN.

G. G. Cole,
 County Surveyor.

*Stone

354.8

BENTON ST.

101.6

50.8

404
53.4

292