


Millersburg

No 345

669

Jackson Street

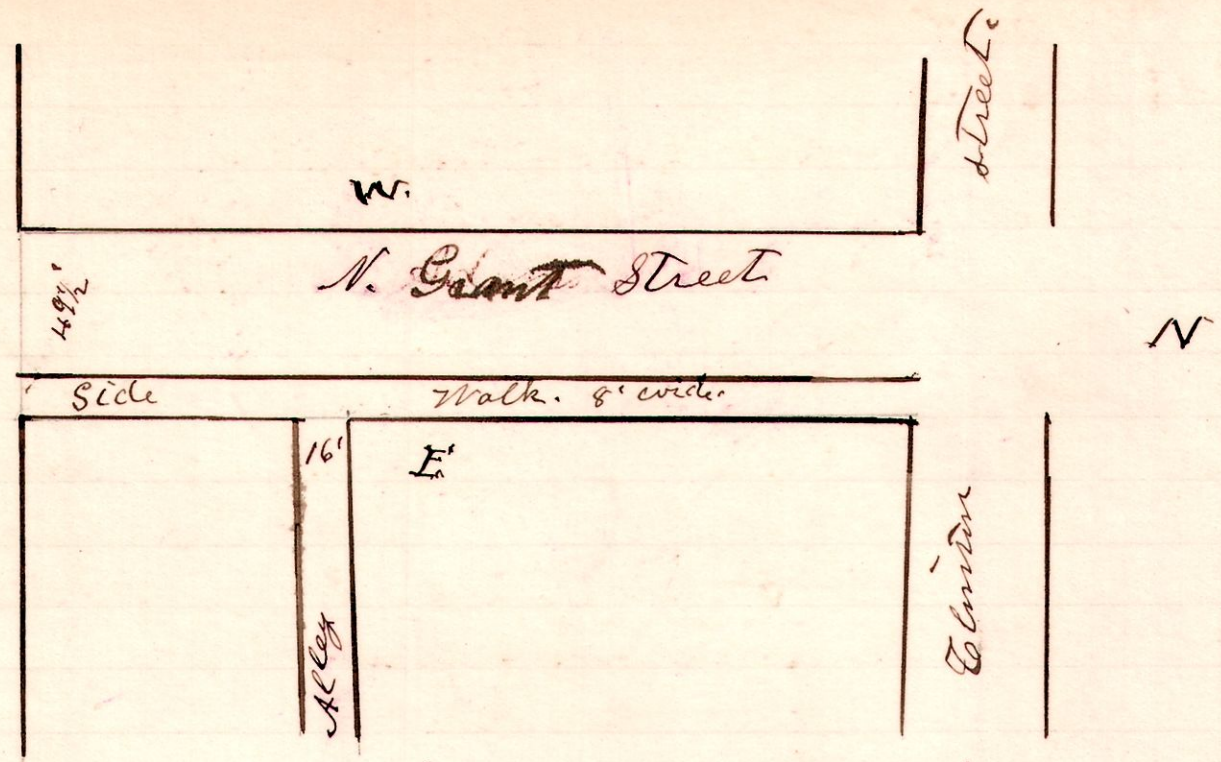


Established grade for curbing and sidewalk on East side of North Grant Street from Jackson to Clinton Street, under the direction of Harry Schlupe, Chairman of sidewalk committee.

Commencing at North end of curbing placed for street improvements (1901). Thence north to Alley at depression of  $1\frac{90}{100}$  feet; Thence commencing at north side of Alley, and running north to North west corner of present curbing at lot Number 249, at a depression of  $4\frac{43}{100}$  feet.

October 29<sup>th</sup> 1901

H. H. Robinson  
County Surveyor &  
Village Engineer

Millersburg No 346

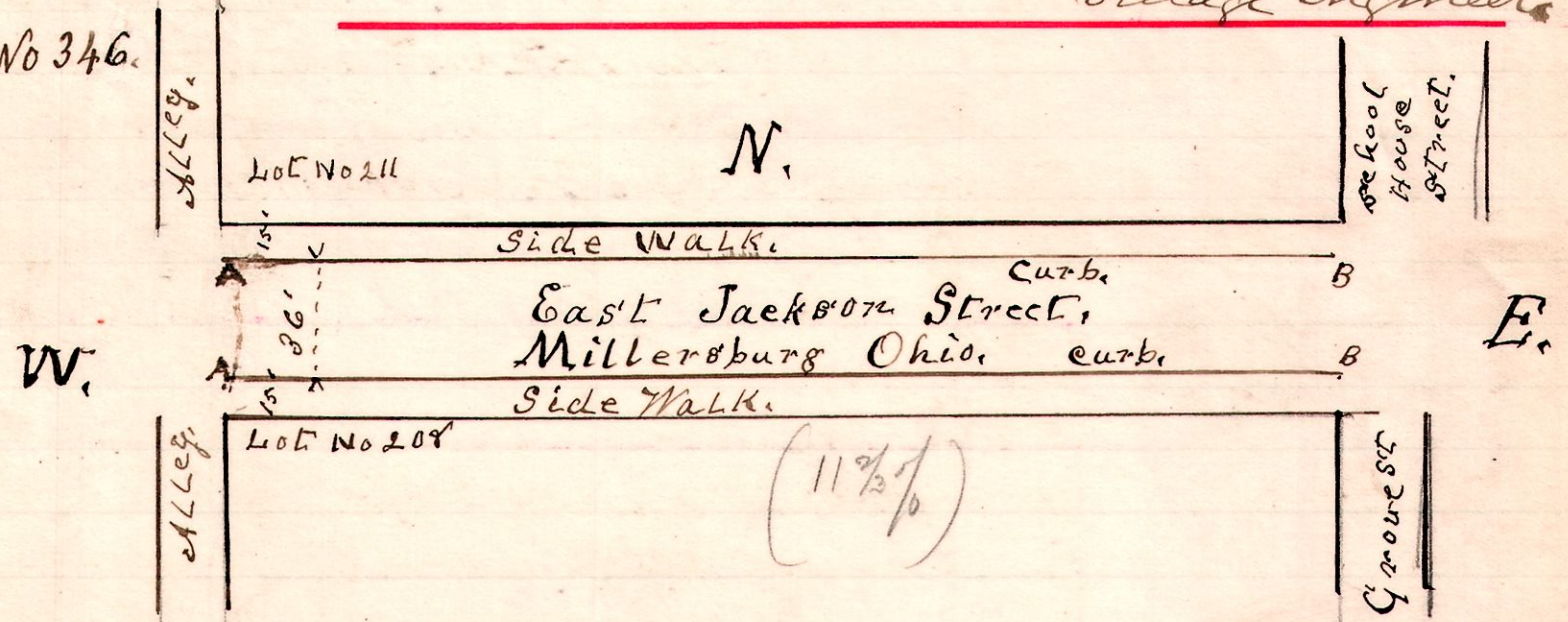

Grade of East Jackson Street, for setting curbing for side walks, commencing at end of curbing set for street improvement of brick on east side of Alley at lots Nos 208 & 211, Thence east to School House & Grow streets at an elevation of  $18\frac{56}{100}$  feet.

Nov 9<sup>th</sup> 1901

Assistant,  
Guy R Palmer.

H. H. Robinson  
County Surveyor &  
Village Engineer.