


15 19 13

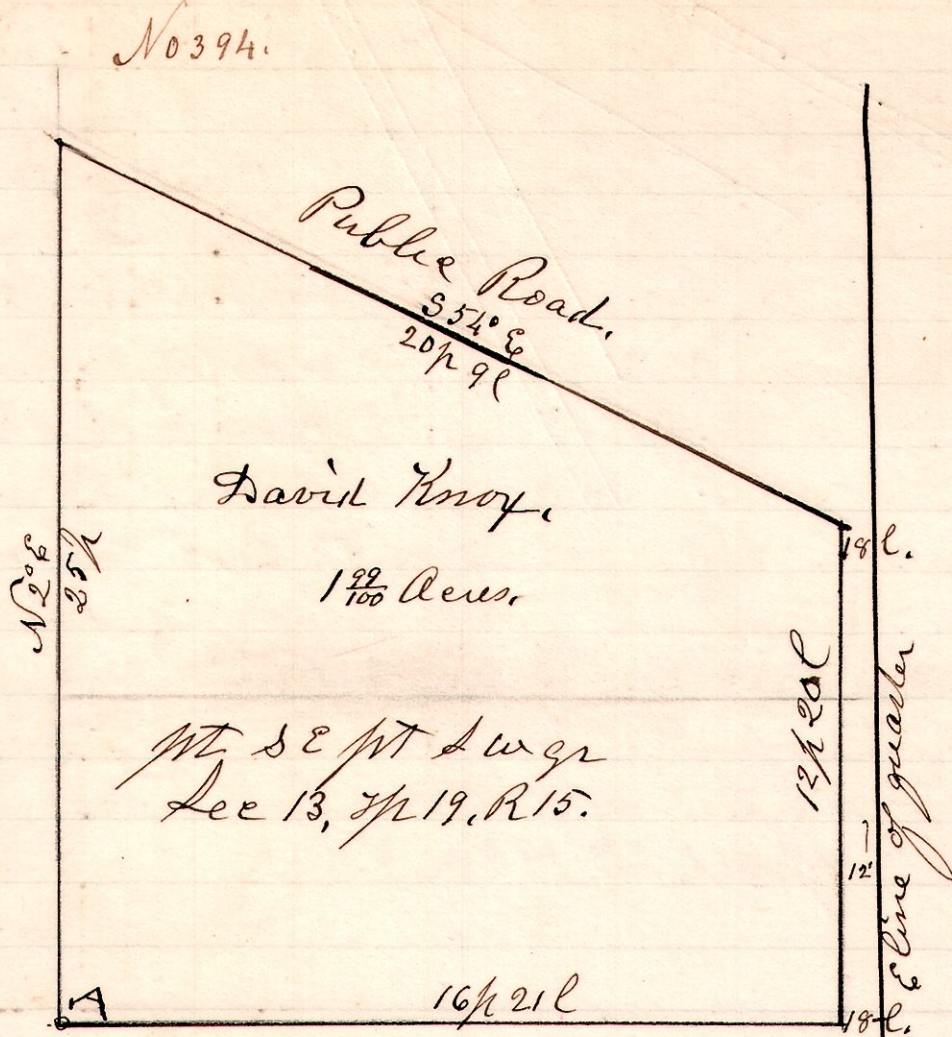


A survey made for David Knox, being a part of the south west quarter of section 13, in Township 19, of Range 15. A is the north west corner of a certain piece of ground sold by David Knox to the Trustees of the Nashville Cemetery March 20<sup>th</sup> 1896, and recorded in Vol 59, Page 467, Deed Record, April 30<sup>th</sup> 1902

H. H. Robinson  
County Surveyor.

Millersburg

No 395

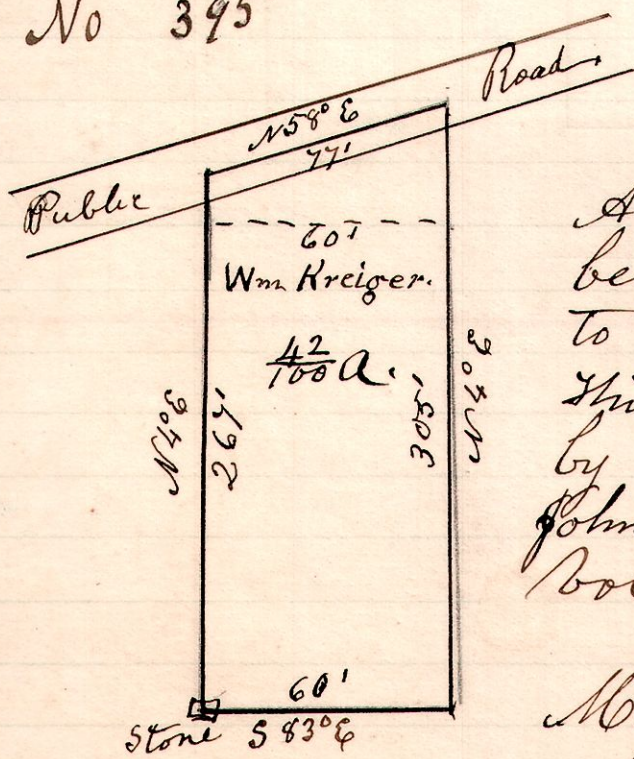

A survey made for Wm Burklew, being part of out lot number 4 to the town of Millersburg Ohio. This lot is bounded on the east by a lot sold by John Horn to John & Miller, and recorded in Vol Page Deed Record,

May 2<sup>nd</sup> 1902

H. H. Robinson  
County Surveyor