


9 8 9

No 484.

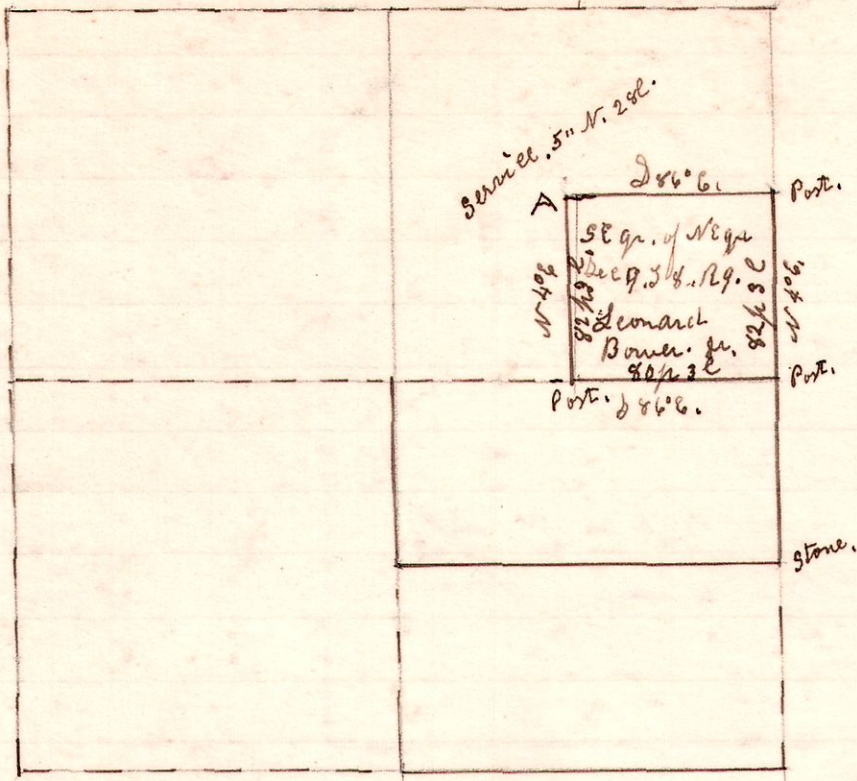


A survey made for Leonard Bower jr. Being the South East quarter of section 9' in Township 8. of Range 9. April 2nd 1903.

H. H. Robinson
County Surveyor.

9 8 9

No 485.

Abstract 5" 8 81° 6' 21"

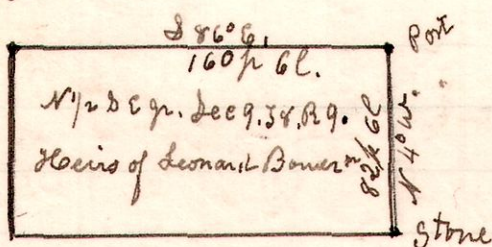


A survey made for George Barns Guardian of minor heirs of Leonard Bower sen. being the North half of the South East quarter of section 9' in Township 8. of Range 9. April 2nd 1903.

H. H. Robinson
County Surveyor.

5 8 6 SW

No 486.

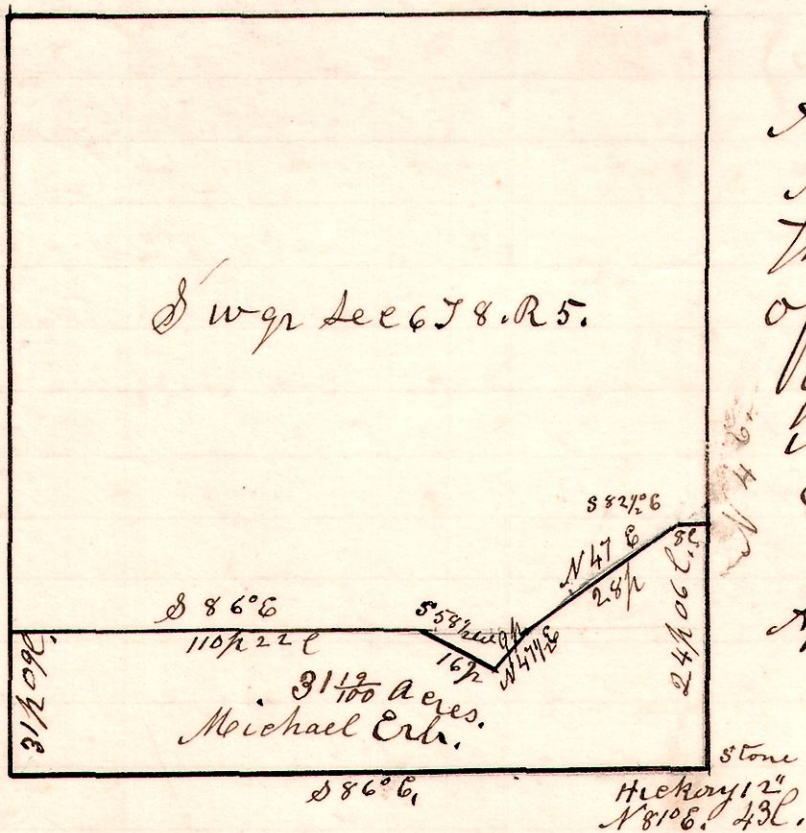

A survey made for Michael Erb being the South West part of the South West quarter of section 6 in Township number 8 of Range number 5. April 17th 1903

H. H. Robinson
County Surveyor.