

No 588


986

Surveyors Report.

To the Commissioners of Holmes County, Ohio:
 The undersigned in obedience to your order dated February 10th 1906
 proceeded on the 14th day of February to survey and mark the alteration
 of County road described in said order, under the direction of the
 Viewers therein named, and respectfully submit the following
 return of said survey:

Commencing in the public road described in the petition,
 on lands owned by Catherine Black, being in the north east
 quarter of the north west quarter of Section 6, in Township
 8 of Range 9: Commencing at a post, with witness: Black Oak
 8 inches in diameter, N 83 1/2° west 35 links; Thence north 34°
 west, 30 perches to a post; Thence north 70° west, 10 perches to
 a post; Thence South 84° west 10 perches & 20 links to a post;
 Thence north 78° west 13 perches to a post; Thence South
 55° west 14 perches to a post in the public road with
 witness, White Oak 16 inches in diameter, South 52° west, 33 links
 on lands of Fred Lo Stitzline, in said north west quarter
 of Section 6, in Township 8, of Range 9. thence to end.

Viewers.
 John M Patterson
 Theodore Allison
 John F Anderson.

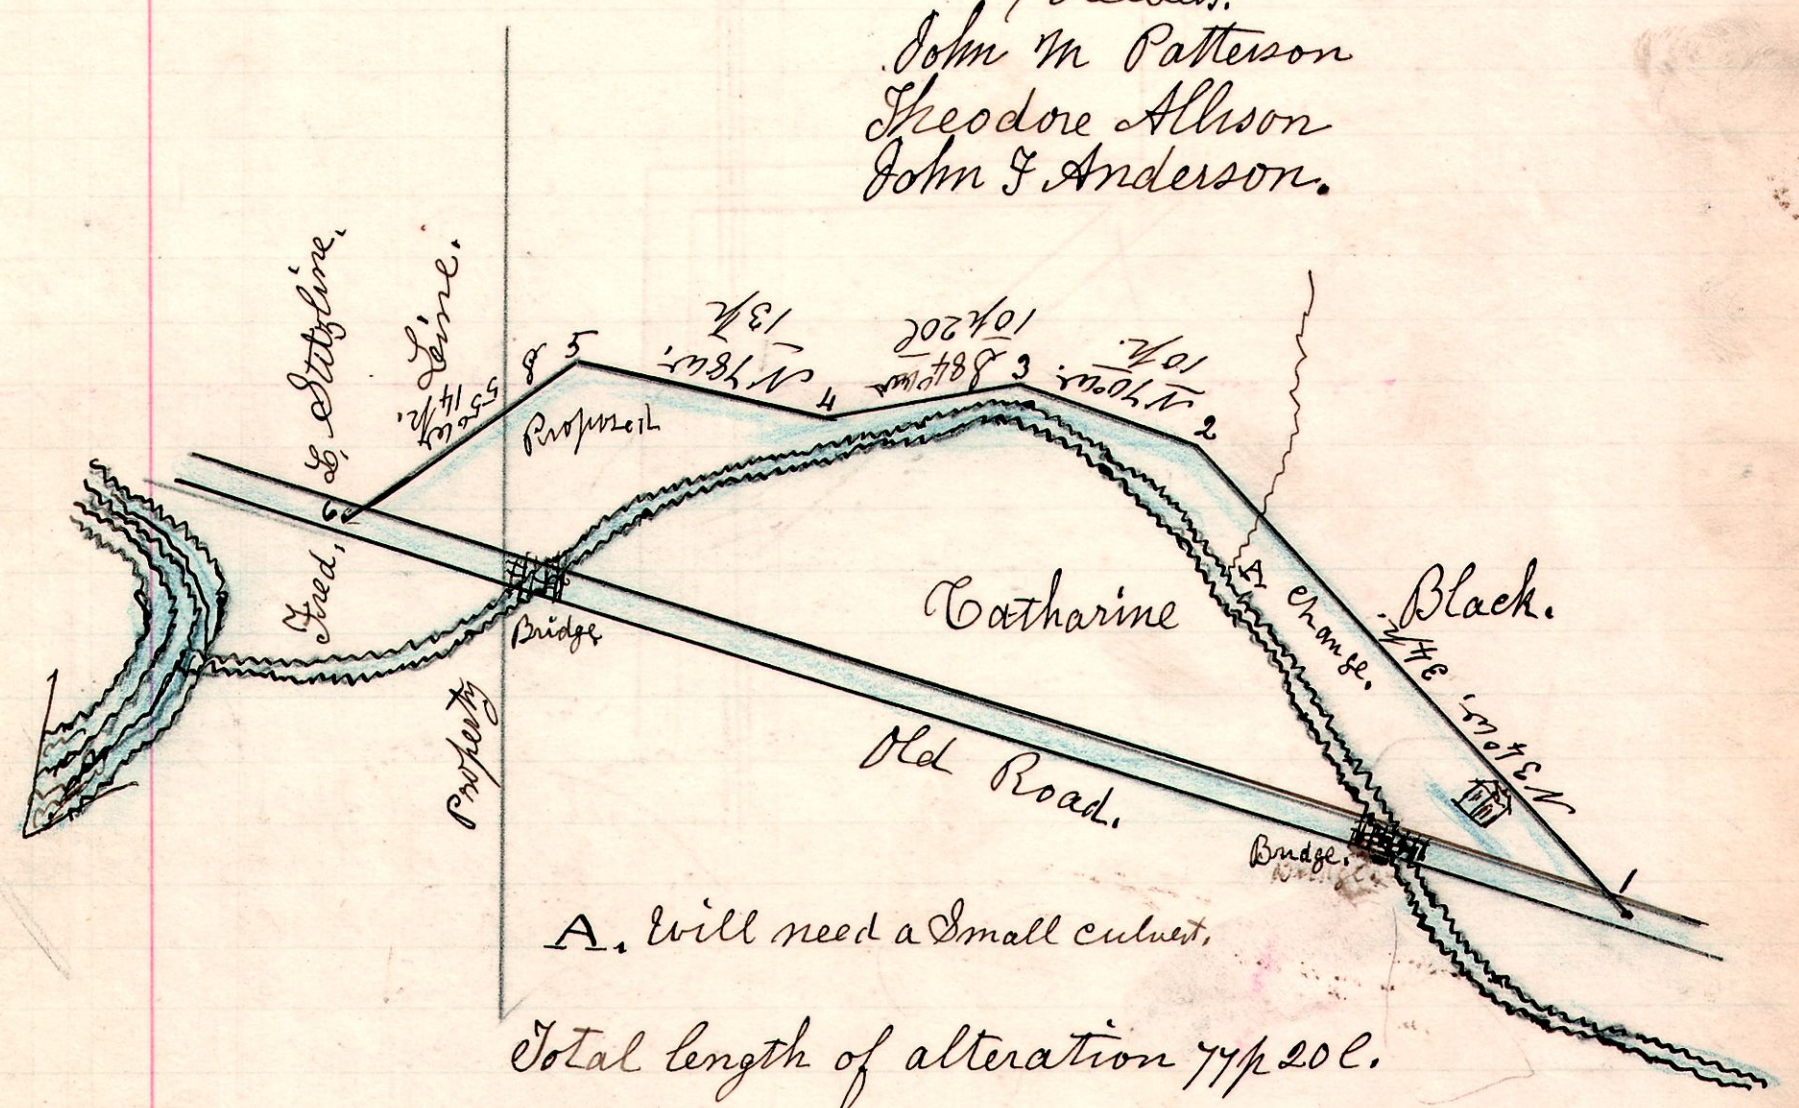

I certify the above to be a correct plat and return of the
 alteration named above,

H. H. Robinson,
 Surveyor of said road alteration.

February 14th & 15th 1905.