


7 8 6 1/2

No 606

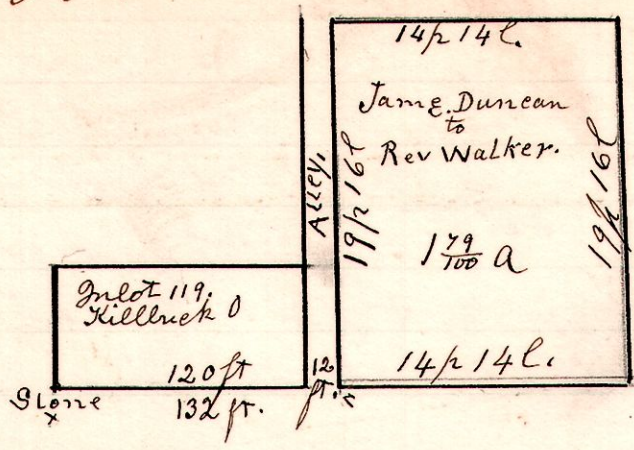


A Survey made for James & Duncan Being part of the South half of Sec 6, T⁸ R⁷. Commencing 132 feet south 85° east from a stone the south west corner of Inlet 119 in the village of Killbuck, and said lot 119 being in James & Duncan's addition of lots to said village.

May 9th 1906.
H. W. Robinson
County Surveyor.

No 607

old Indian Boundary line.

9 9 1/2 lot 13
C. B. D. 1796. 27 l

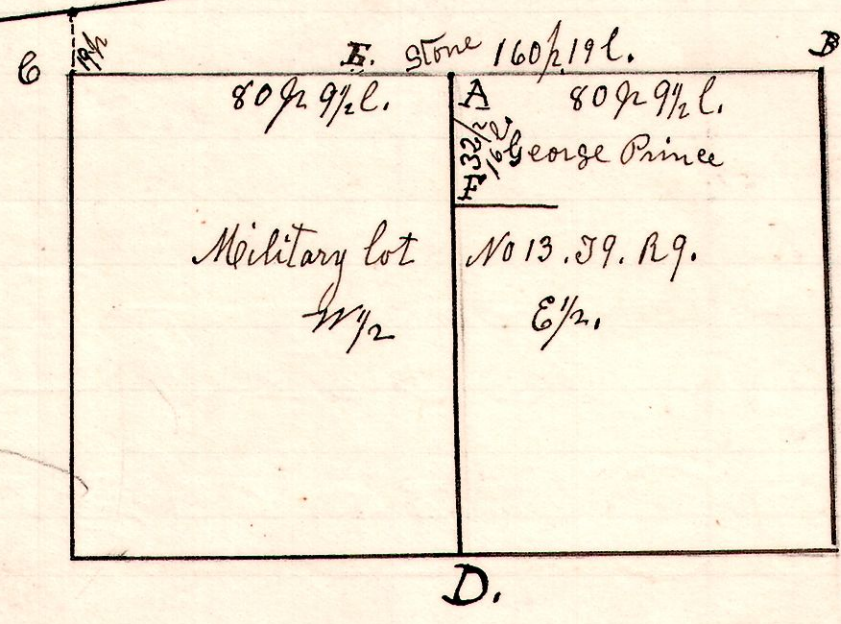

A legal survey made for George Prince and others, to locate the corner A, and the line between George Prince and Charles Rodenhafers land. I first located the line B.C. then the corner A, on the north line of said lot 13.

The line B.C. measured 160 1/2 19 l. being 80 1/2 9 1/2 l to each half of said lot. On October 28th 1901. I surveyed the line A.D, getting the corner A by measuring from a stone at E, as shown me by Charles Rodenhafers as the corner of his lot, the distance called for in his deed. On this present survey made May 29th 1906, the center of the line C.B. came 7 links west of the 1901 survey, I then moved the 1906 survey east the 7 links to where the 1901 corner stood, which was not objected to by any parties present. I then ran the line A.D, and established the corner F the south west corner of Princes land

4) 58
78