


12 15 28,

No 620.

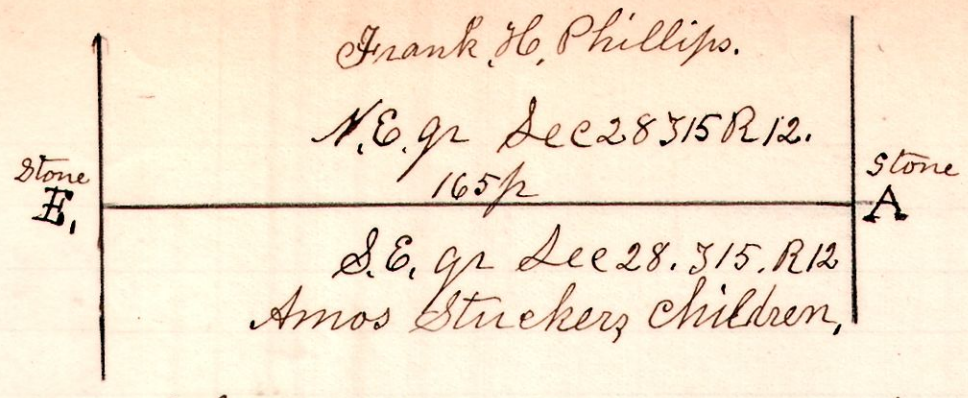

A legal Survey made at the request of Frank H. Phillips. to locate the property line A, B, being the between the north east & the South East quarters of Section 28, in Township 15, of Range 12.

April 16th 1907.

I found a corner stone planted at both ends of the line which I verified by a white oak stump at "A" and living white oak at "B".

Present Victor Beaman, Amos Stueker, Frank H. Phillips Wm Miller, Victor Beaman & Wm Miller were sworn by me as flagmen & Foster Stueker & Frank H. Phillips chainmen.

Survey made the 20 days notice as required by law.