


9 8 5

623

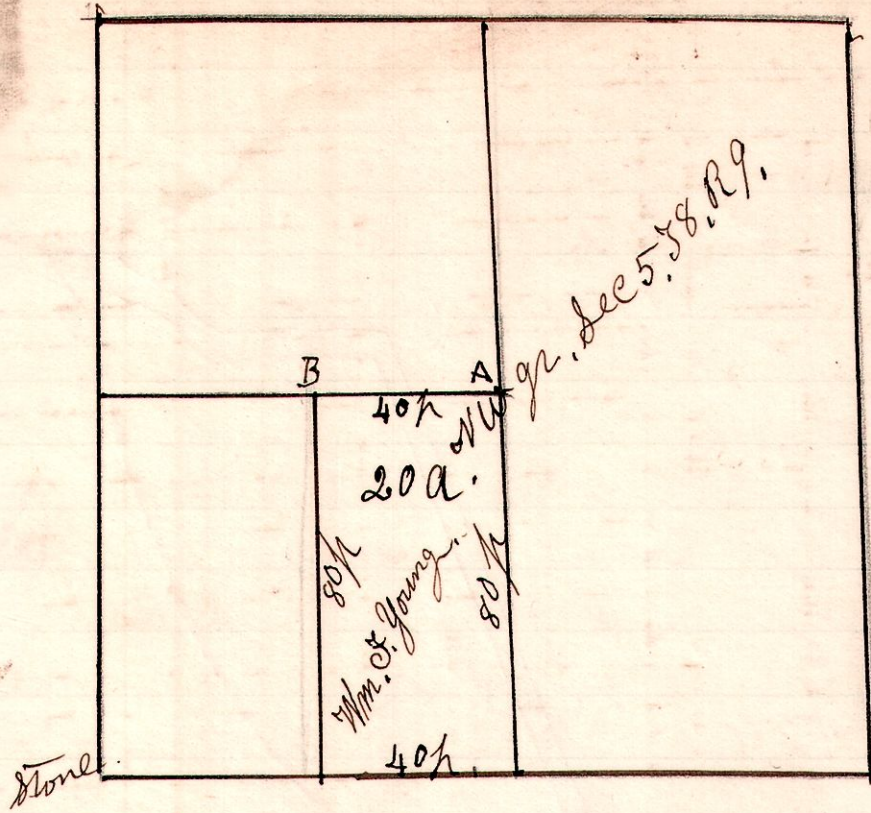

A Survey made for
 Wm F Young, Being the
 East part of the South
 west quarter of the
 north west quarter
 of Section 5 in
 Township 8 of Range 9.

A. width 16. w 10 l.
 B. chestnut 5" & 76 & 8 l.

April 29th 1907.


H. H. Robinson
 Co Surveyor

Chainmen, marker & Flagmen,
 Wm F Young,
 E. A. Stitzline
 Chs Jeanguen
 Philip Hawkins
 Martin Stitzline
 J. C. Stitzline.

Berlin.

624

Sec 15- 99. R 5

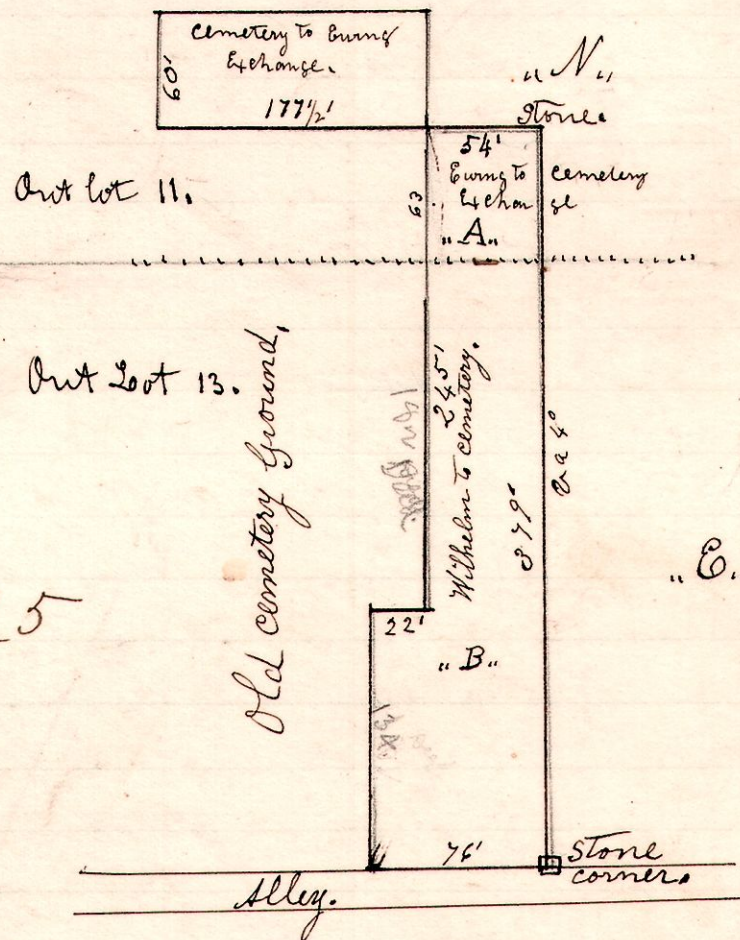

A Survey made for the Trustees of Berlin Sp,
 being additional grounds for the Township Cemetery.
 The tract "A" is part of out lot No 11. to the town
 of Berlin & tract "B" part of out lot No 13 to
 said town of Berlin.

May 9th 1907

Trustees,
 John Burkey,
 Boyd,
 George Schnell.

H. H. Robinson,
 County Surveyor.