


630

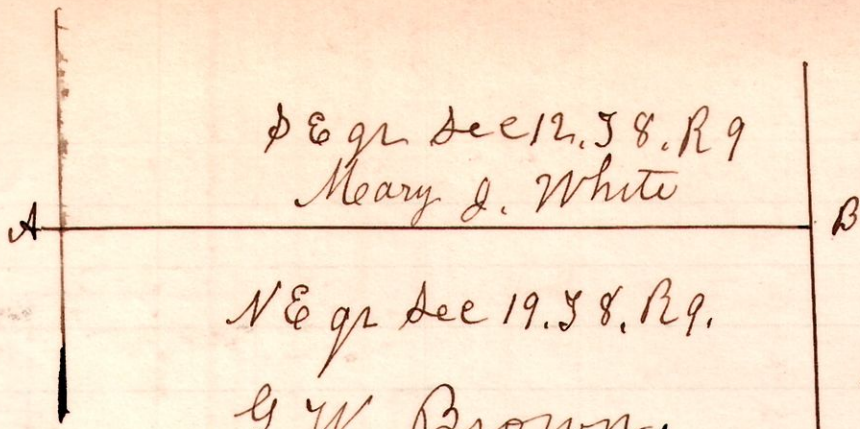

SE qr Sec 12. 58. R 9
 Mary J. White

NE qr Sec 19. 58. R 9.
 G. W. Brown.


A survey made for
 Dr. S. P. Wise, guardian
 of Mary J. White, to locate
 the line A. B.

Nov. 13th 1907.

H. H. Robinson
 Co Surveyor.

68 2^{qr}

631

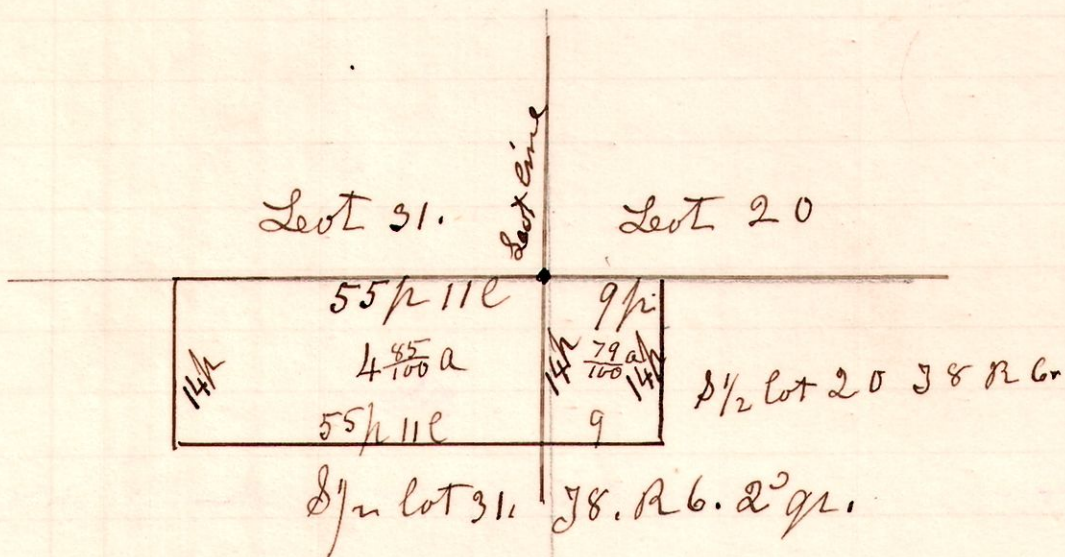

A survey made for Henry and Wm C Patterson


Nov. 22nd 1907.

H. H. Robinson
 Co Surveyor.

632

Millersburg

SW corner of
 S. B. Jones land

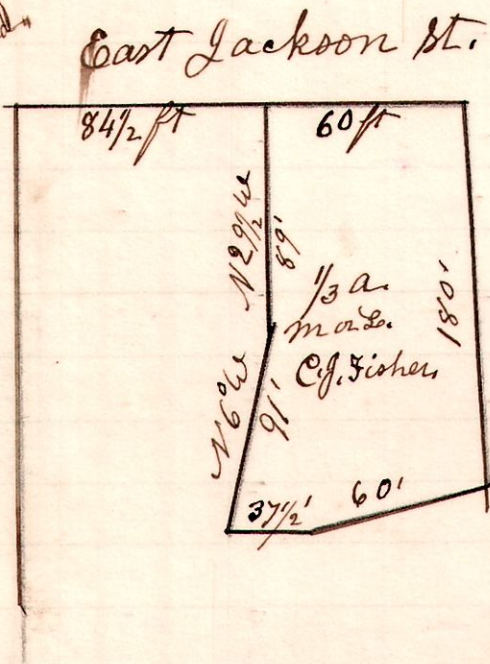

A Survey made for S. B. Fair,
 being part of out-lot No 4, to
 Millersburg.

Nov 29th 1907.

H. H. Robinson
 Co Surveyor.