


641

15, 20, 36

Sec 36. T 20 R 15


A survey made for G. A. Raby being part of the east part of the south east quarter of section 36, in Township 20, Range 15 particularly to locate the line A. B. so the Township Trustees can divide the fence to be built on said line.

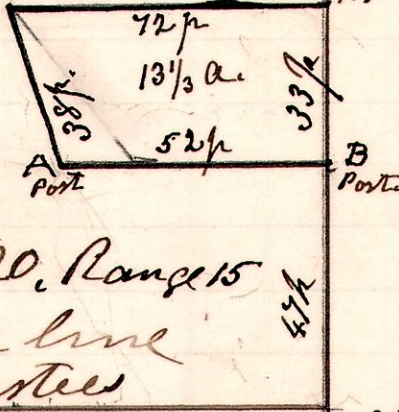

W. W. Spieng and Parsons chain carriers.
 January 7th 1908
 H. H. Robinson
 County Surveyor.

981

642

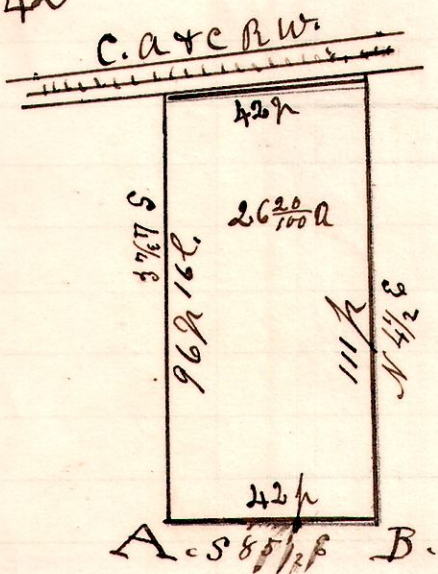

A survey made for Peter Fry, being the south east part of the west half of the south east quarter of section 1, T 8, R 9.

A, W. Oak 18" South, 8 l.
 B, Ironwood 5" S 88° 6', 10 l.
 " - W. Oak 5" S 36° 6', 10 l.

Syon chain carriers.
 Sam Nye.
 Ed Reichel.
 Assistant Surveyor H. H. Palmer.

January 28th 1908.

H. H. Robinson
 County Surveyor.