

8 9 ^{2nd} ^{3rd} Lot 11
 fr. 19. 10 24

TR 452

Survey made for County Commissioners for Alteration of County Road
 In Monroe Tp. Holmes County Ohio.


June 24, 1910.

N. O. Miller }
 C. O. Koehler } Viewers
 J. F. Calhoun }

N. L. Reidenbach - Surveyor.

We took to our assistance
 Harris H. Palmer, and John McCalla
 as chairman and M. R. Gilbert
 as marker and proceeded to
 view, survey and lay out
 said Road as shown on plat
 herewith. The courses and
 distances are as shown herewith
 Place of beginning is
 Sta. 0, is a stone in the middle of old LINE
 Road on farm of M. G. Bird. Lot. 10. ^{3rd} fr. 9. R. 8.
 Witnessed Jack Oak 24 N 54 1/2 W 3 4 1/2 ch.

Sta.	Course	Ch.	Links
0	N 52° 45' W	5	02
1	N 50° 38' W	1	37
2	N 43° 00' W	2	30
3	N 38° 36' W	4	17
4	N 45° 46' W	2	14 1/2
5	N 56° 46' W	1	73
6	N 61° 36' W	2	27
7	N 45° 06' W	1	11
8	N 16° 59' W	1	07
9	N 8° 53' W	2	82
10	N 7° 19' E	1	36
11	N 22° 39' E	11	48
12	" 16° 04' E	2	11
13	" 8° 00' E	3	79
14	" 3° 00' W	4	12
15	" 8° 36' W	2	87
16	" 8° 10' W	5	48
17	End. Post in Road.		
Total.		52	83 1/2

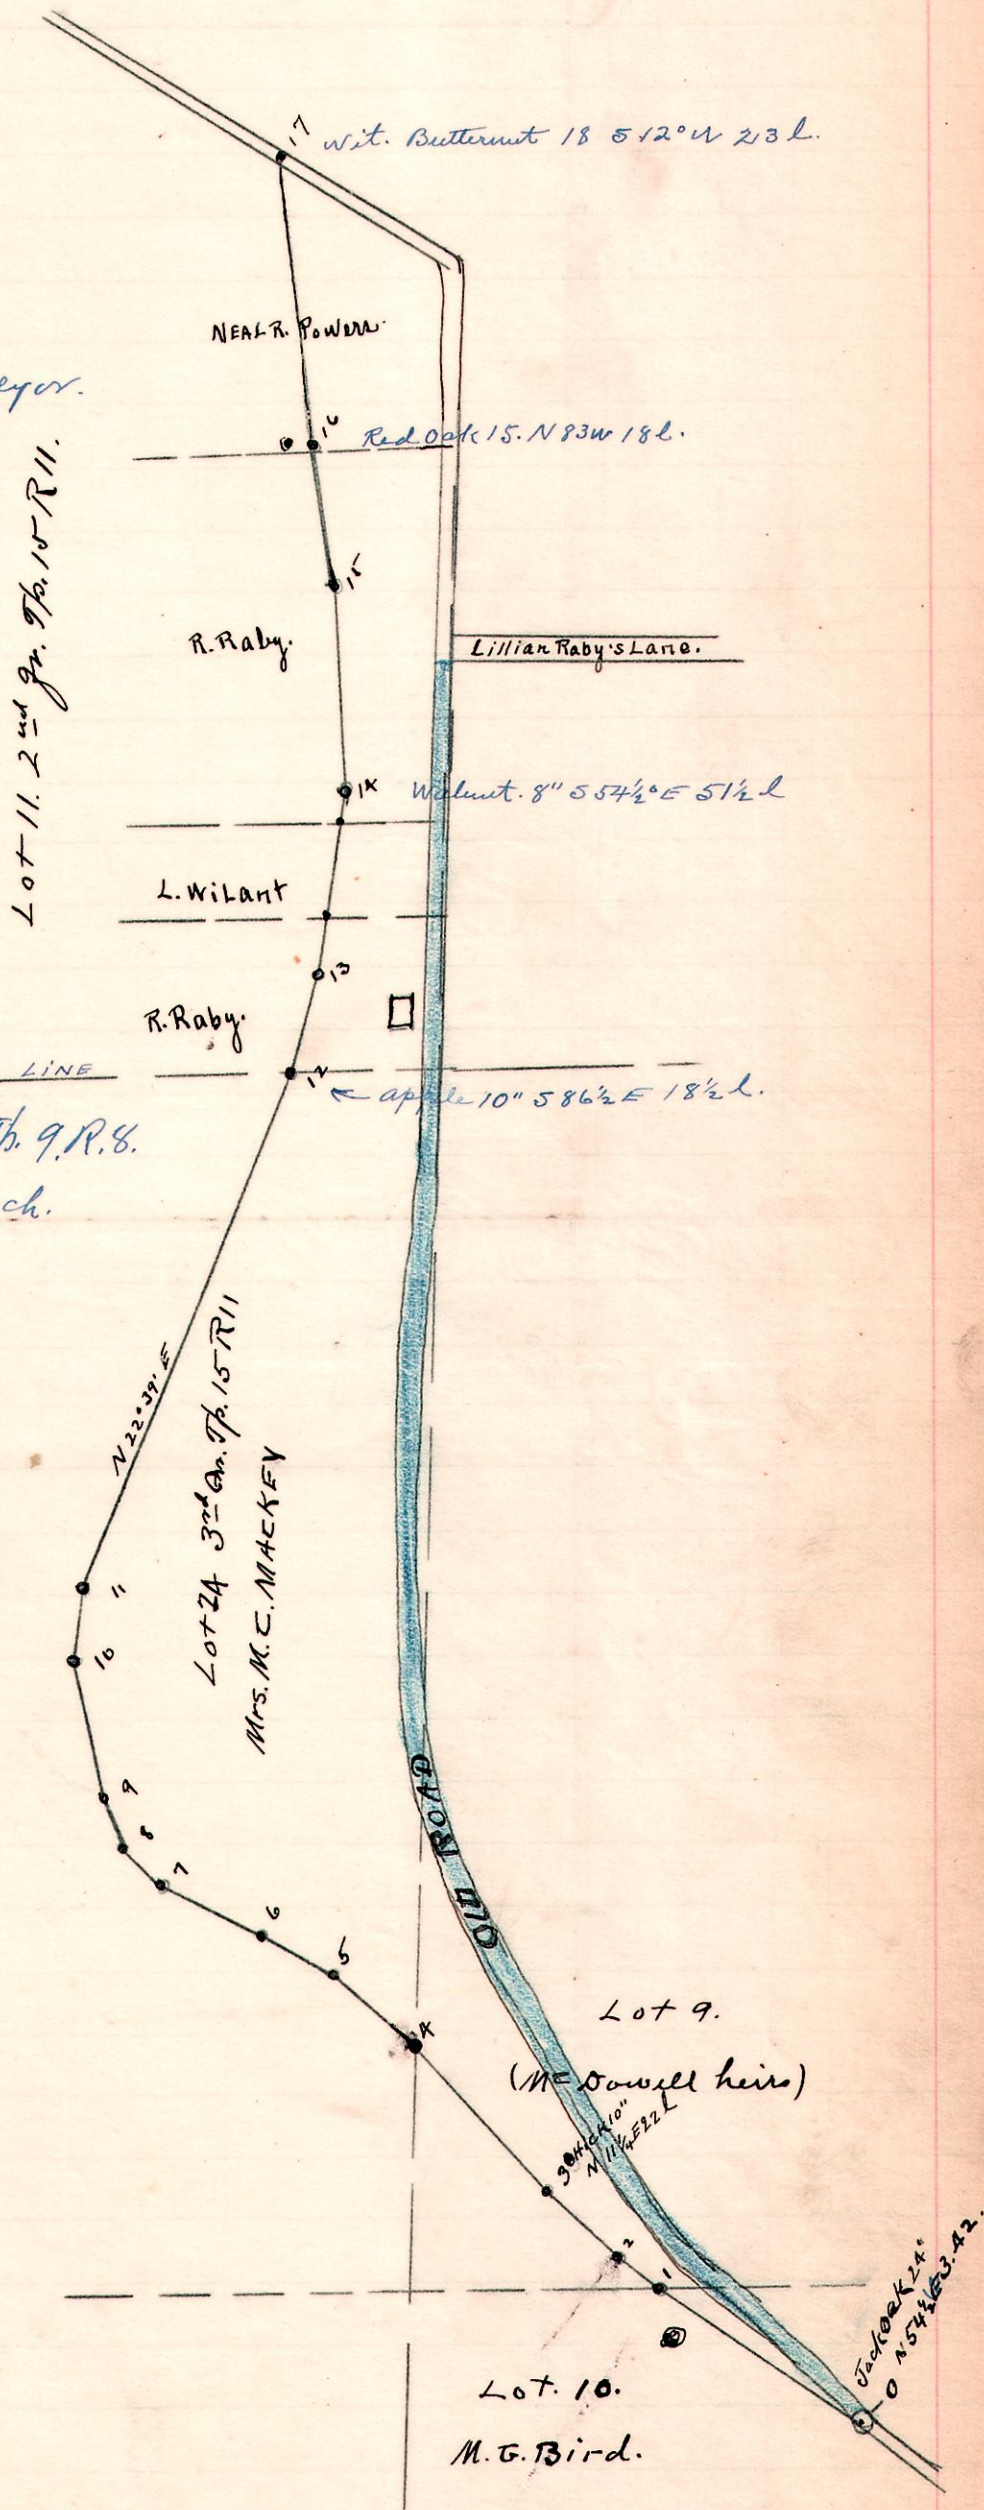

I certify the above a correct copy of notes of said
 Survey.

June 24, 1910

N. L. Reidenbach
 Co. Surveyor