


13 13 16th West

Surveyed for Scott V. Hellen Mast. March 23, 1910 to establish corner "B"
 Located corner from Root of old Mt. N.O. 18 N 61° E 24. blown down and decayed.
 Took new witness. Maple 3 N 80 W 1 l

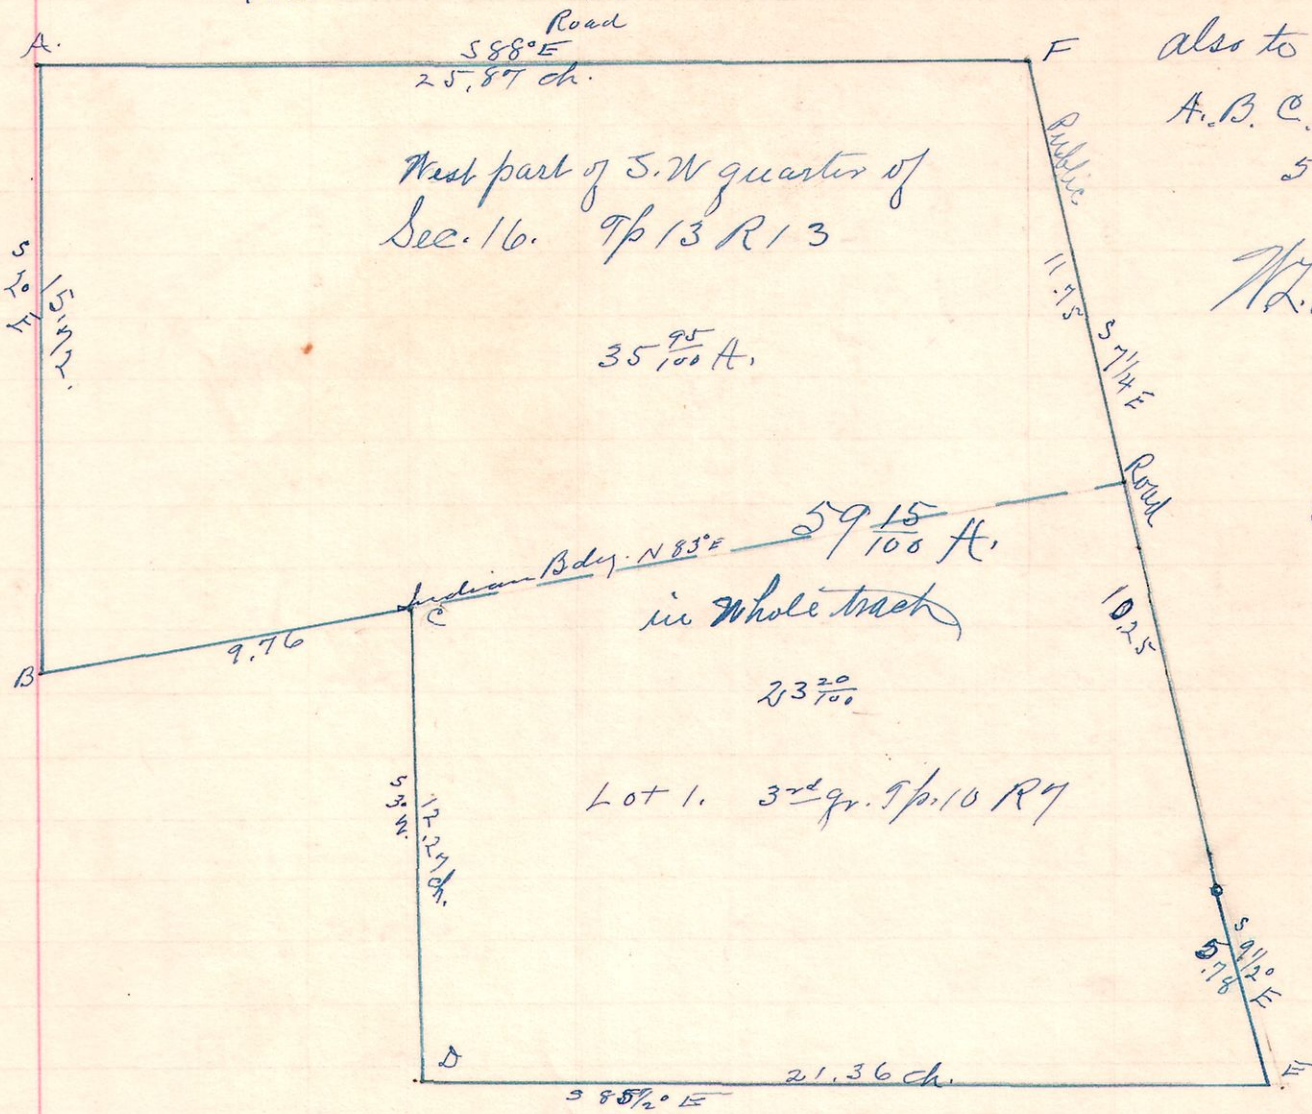


also to determine area of
 A. B. C. D. E. F.
 59 ¹⁵/₁₀₀ Acres.

W. L. Reidenbach
 Co. Surveyor

7 8 6th West (Part)

Survey made for J. B. Purdy + Daw Deetz to cut off 10 acres.
 Reserved in deed made to Daw Deetz.
 Chain carriers J. B. Purdy + Daw Deetz

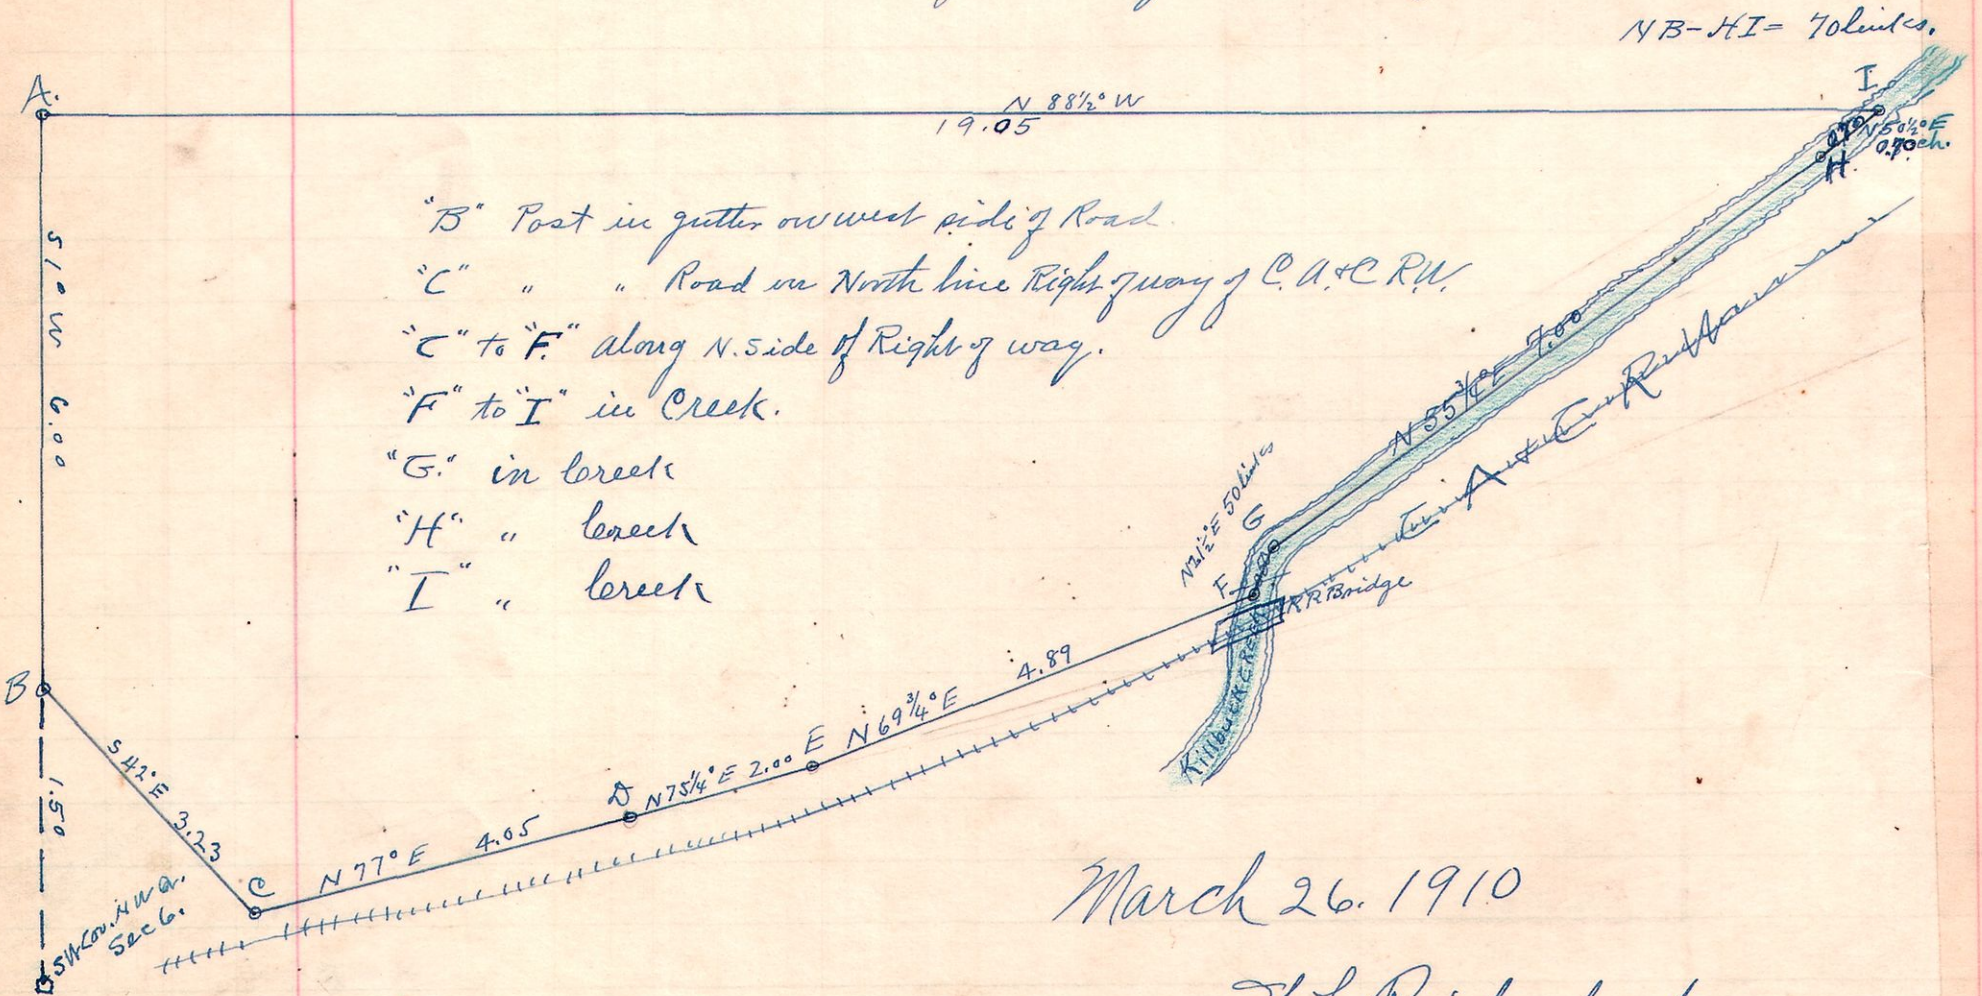

- "B" Post in gutter on west side of Road.
- "C" " " Road on North line Right of way of C. A. + C. R. R.
- "C" to "F" along N. side of Right of way.
- "F" to "I" in Creek.
- "G" in creek
- "H" " creek
- "I" " creek

March 26, 1910

W. L. Reidenbach
 County Surveyor