


Survey made of Margaret Ruble lands in Knox and Richland
Twp. by Court Order 7/4/42

Harold H. Uhl

T R SEC. QR.

9 9 23 SW

NW. Cor. SW. QR. Sec. 13 Stone 584°30'E 10.20 Stone

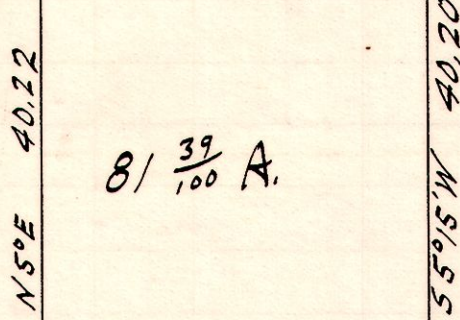


81 ³⁹/₁₀₀ A.

NW. Cor. NW. QR. Sec. 3 7-8, R-9

9.35 584°30'E 24.20 N84°30'W 20.03 5.17

8 9 3 NW

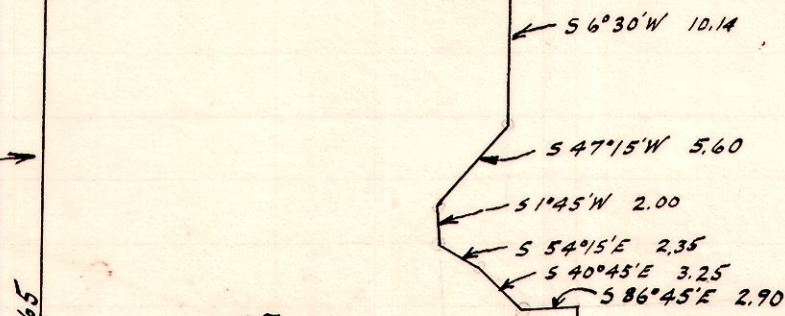

101 ⁶⁵/₁₀₀ A.

NW. Cor. SW. QR. Sec. 3

1.60 584°30'E 28.30 N84°30'W 26.10 2.50

8 9 3 SW

N6°30'W 2.34

8 9 5 NE

S85°E 21.00

42 ⁸³/₁₀₀ A.

N5°30'E 20.40

N84°45'W 20.90

SE. Cor. NE. QR. Sec. 5, T-8, R-9

8 9 5 SE

14 ⁹⁵/₁₀₀ A.

N5°30'E 15.00

S66°W 3.27

S52°45'W 6.81

S59°W 10.30

S66°15'W 5.50