


MILLERSBURG

Sec. T. R

19 9 7

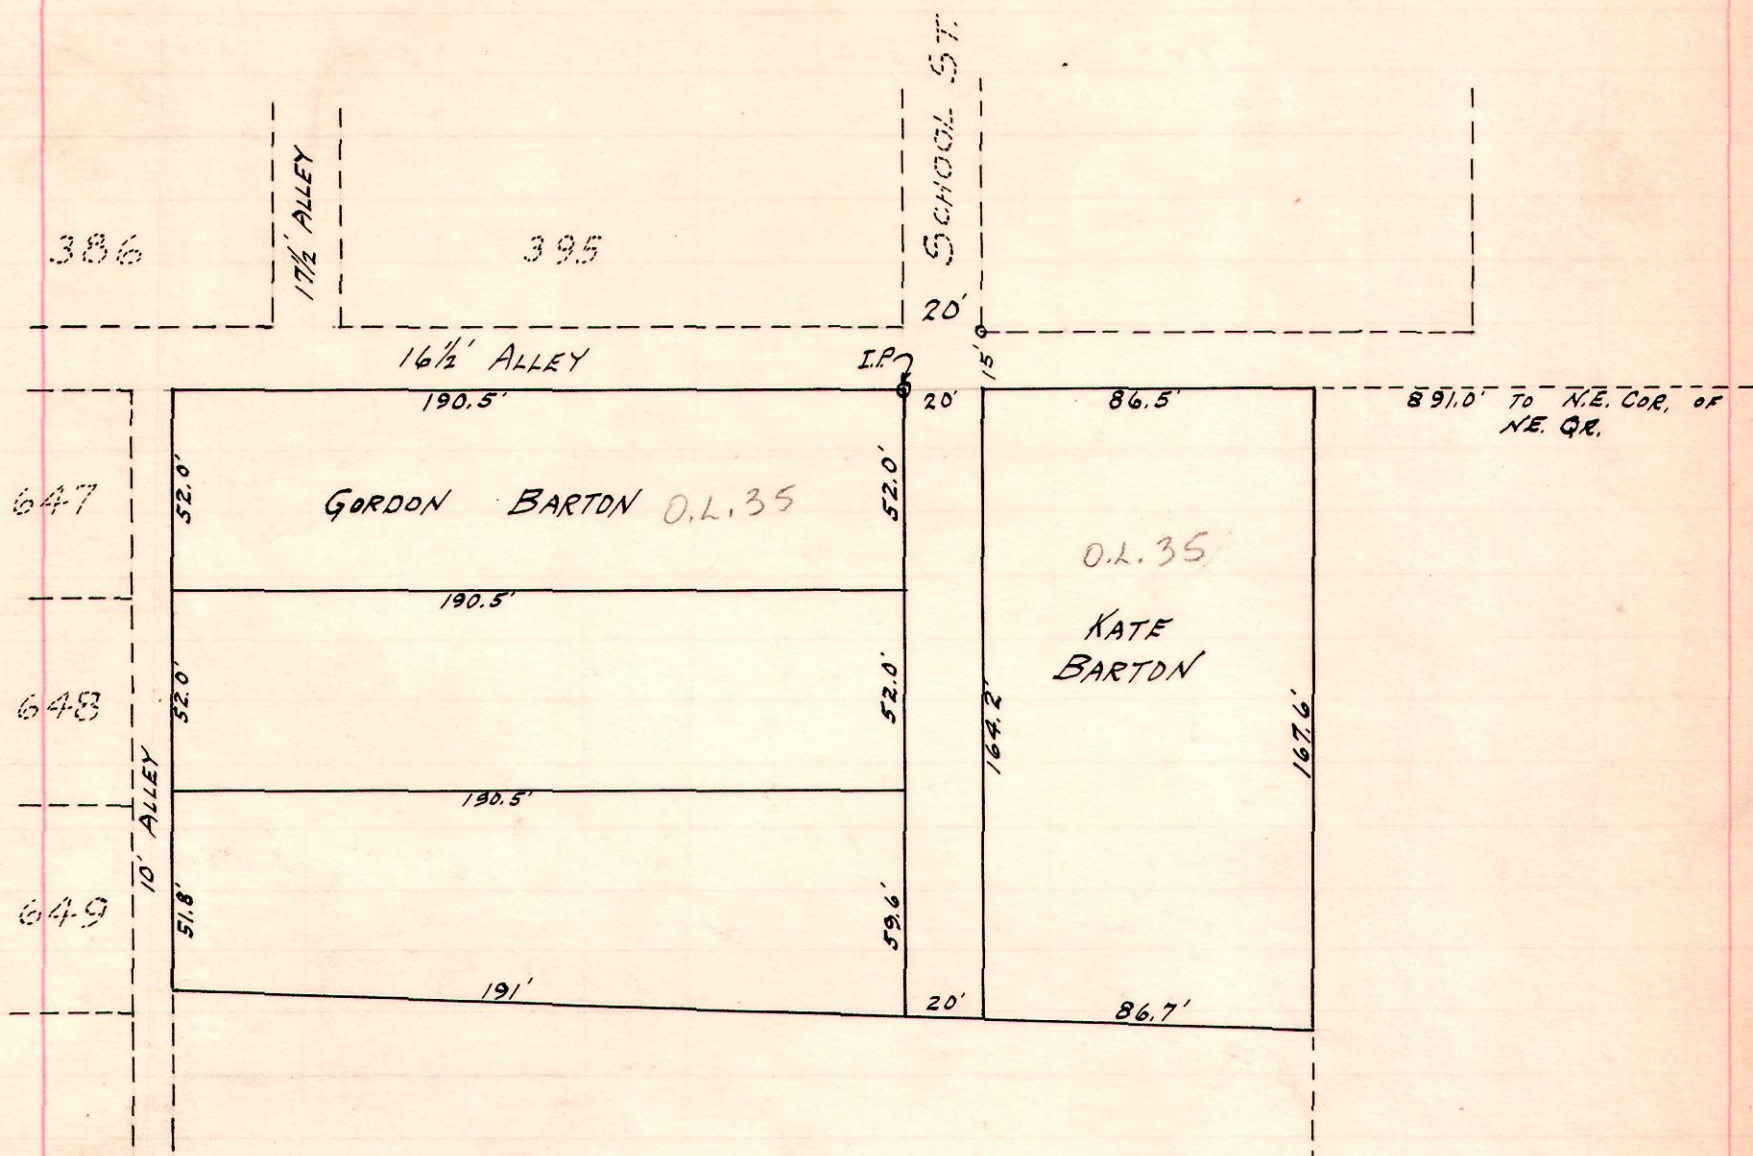

Survey made for Kate Barton to lay out lots in
 W. H. T. March 20, 1941
 W. H. T. H.




I certify this survey to be correct to the best of my knowledge and belief.

J. T. McClure
 2403

