


1418315E
14176NE

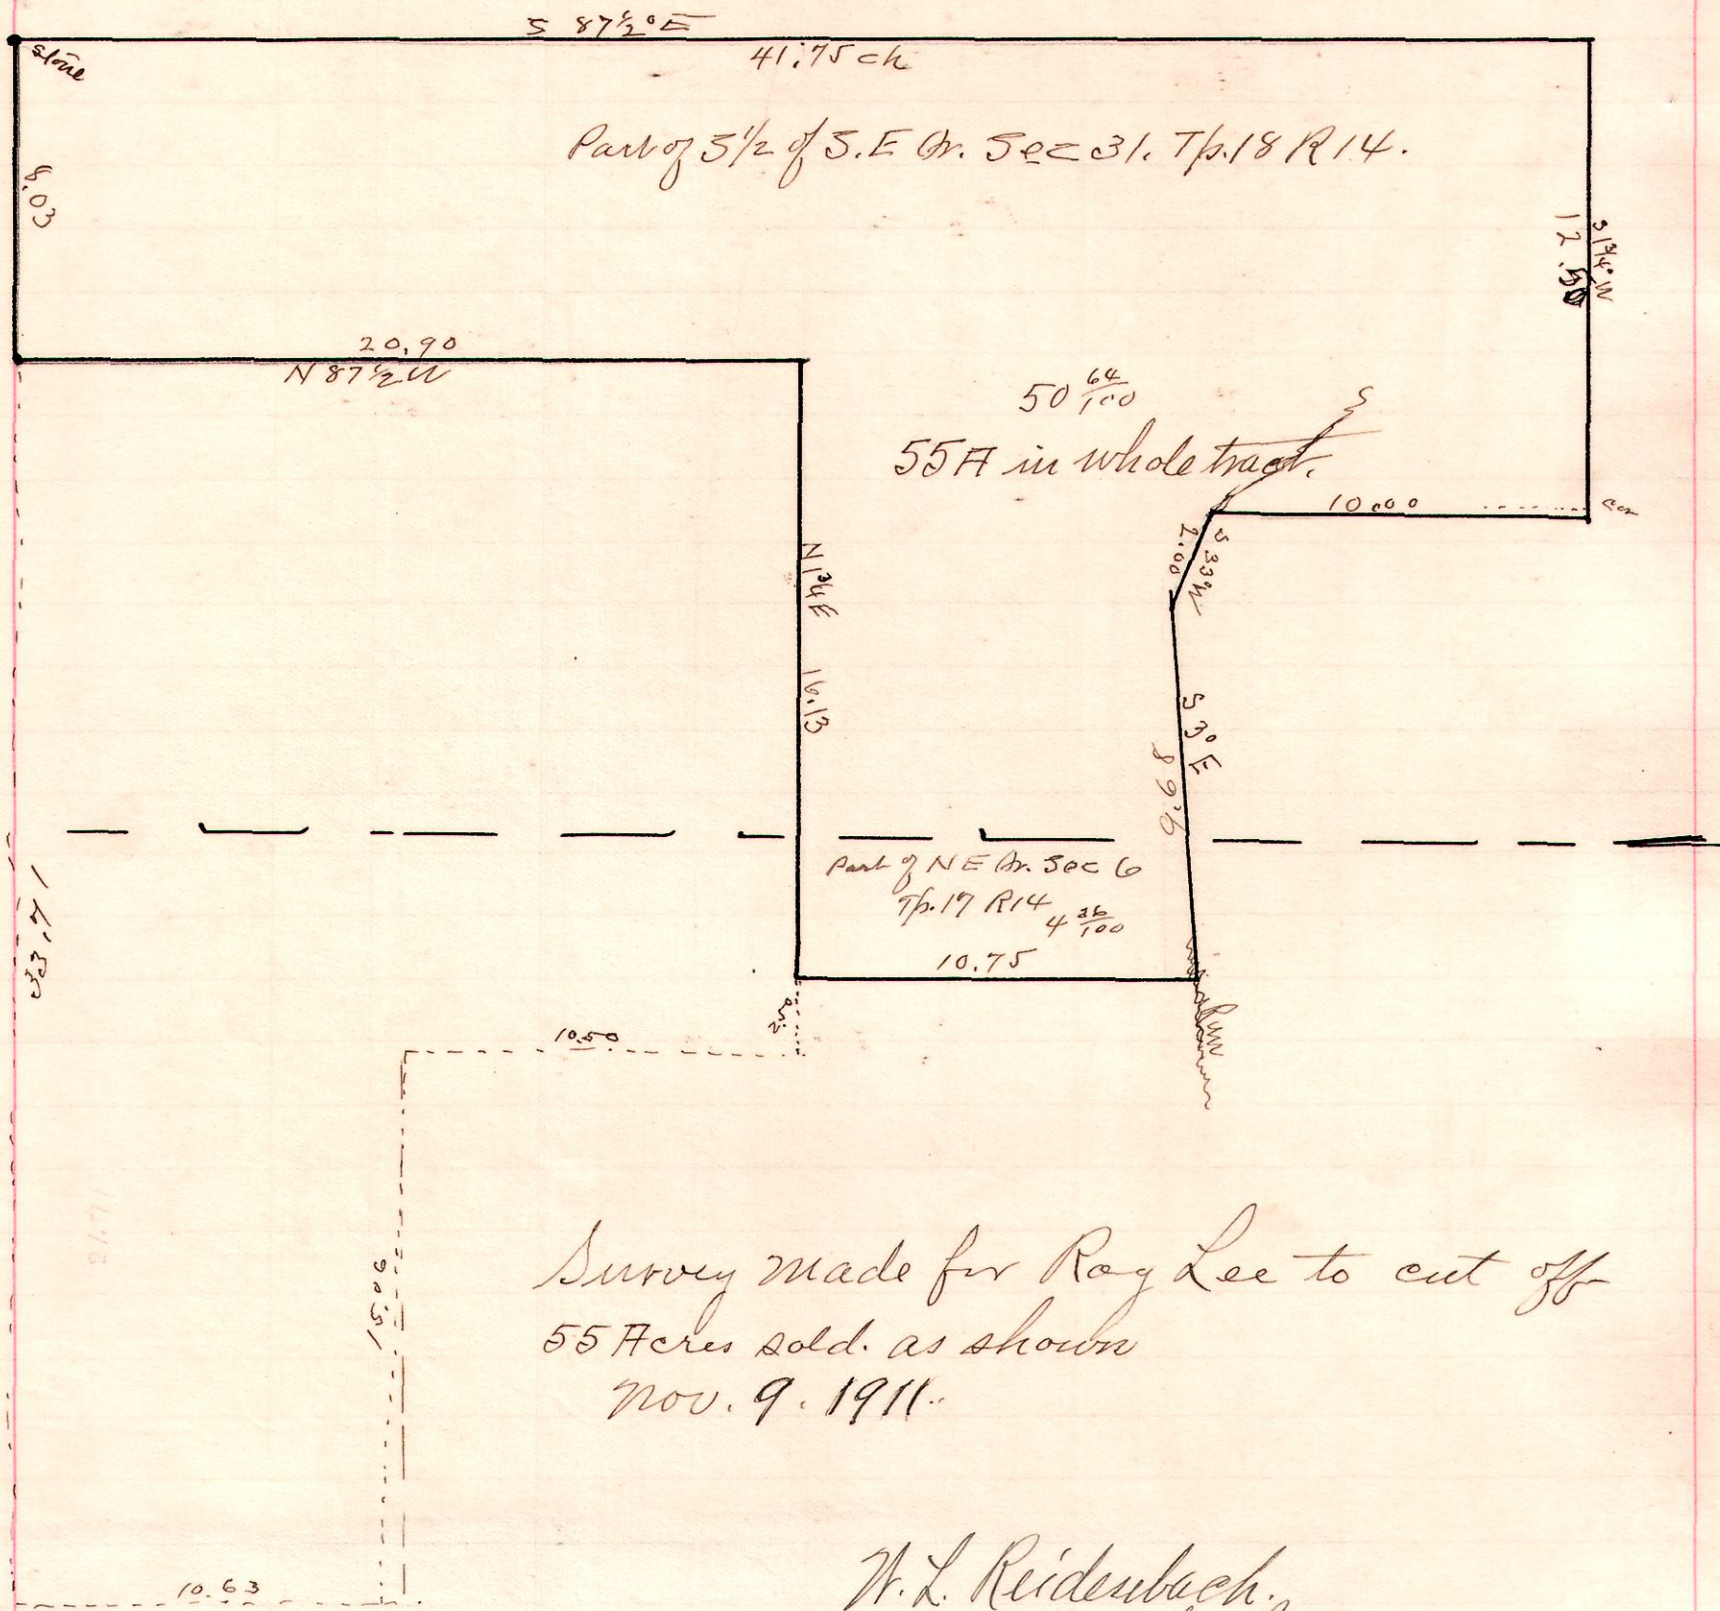

See Survey File