7 9 19 NE Qr. Surveyed line A. B. for Kate Barton to be divisionline for South part sold to I. D. Cline.

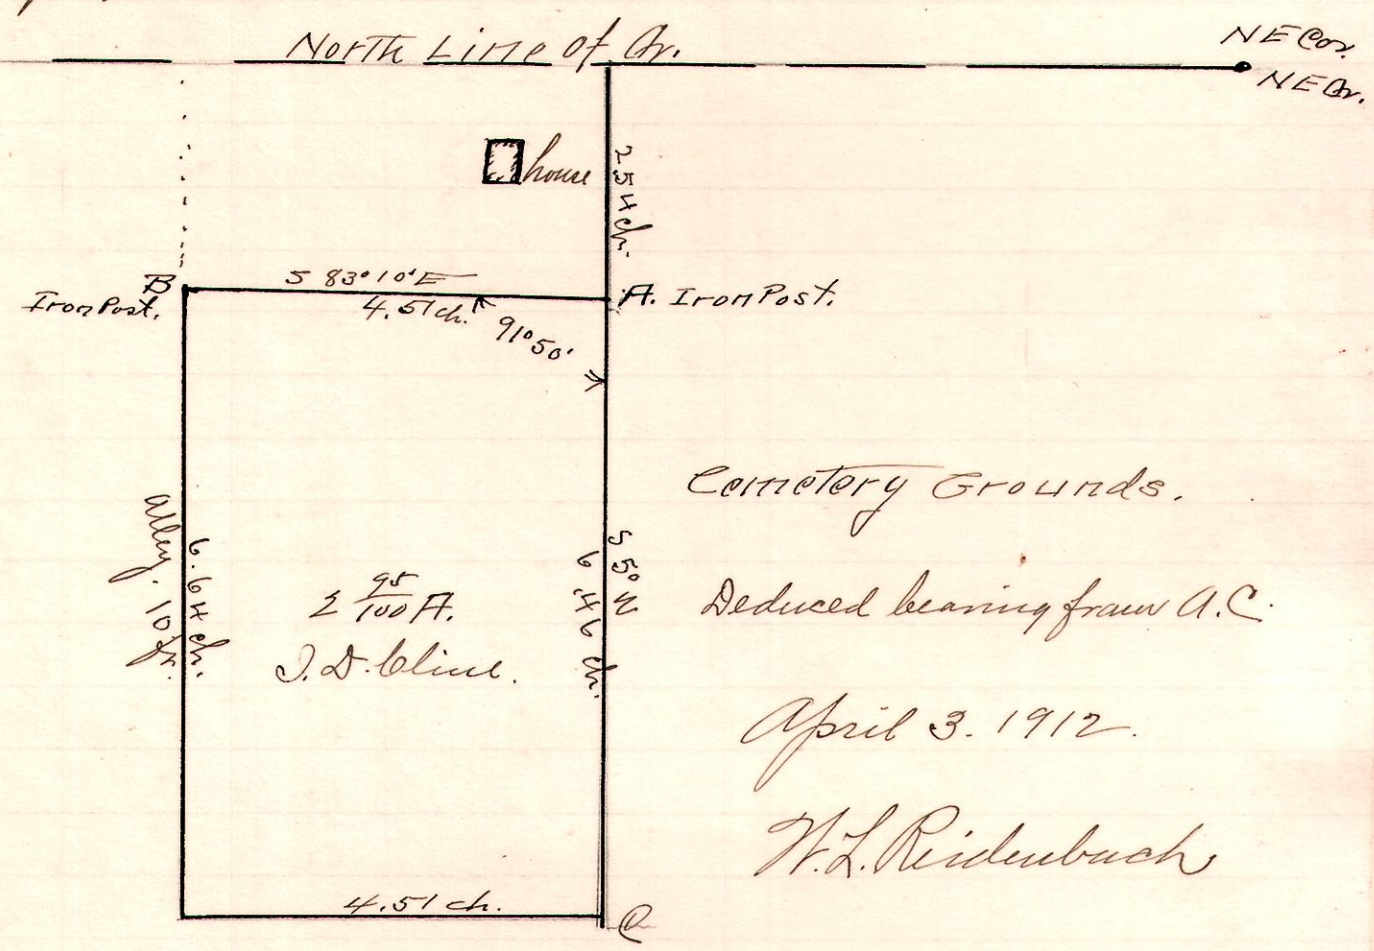

Cemetery Grounds.

Deduced bearing from A. C.

April 3. 1912.

W. L. Reidenbach

5 9 7 NW. QR.

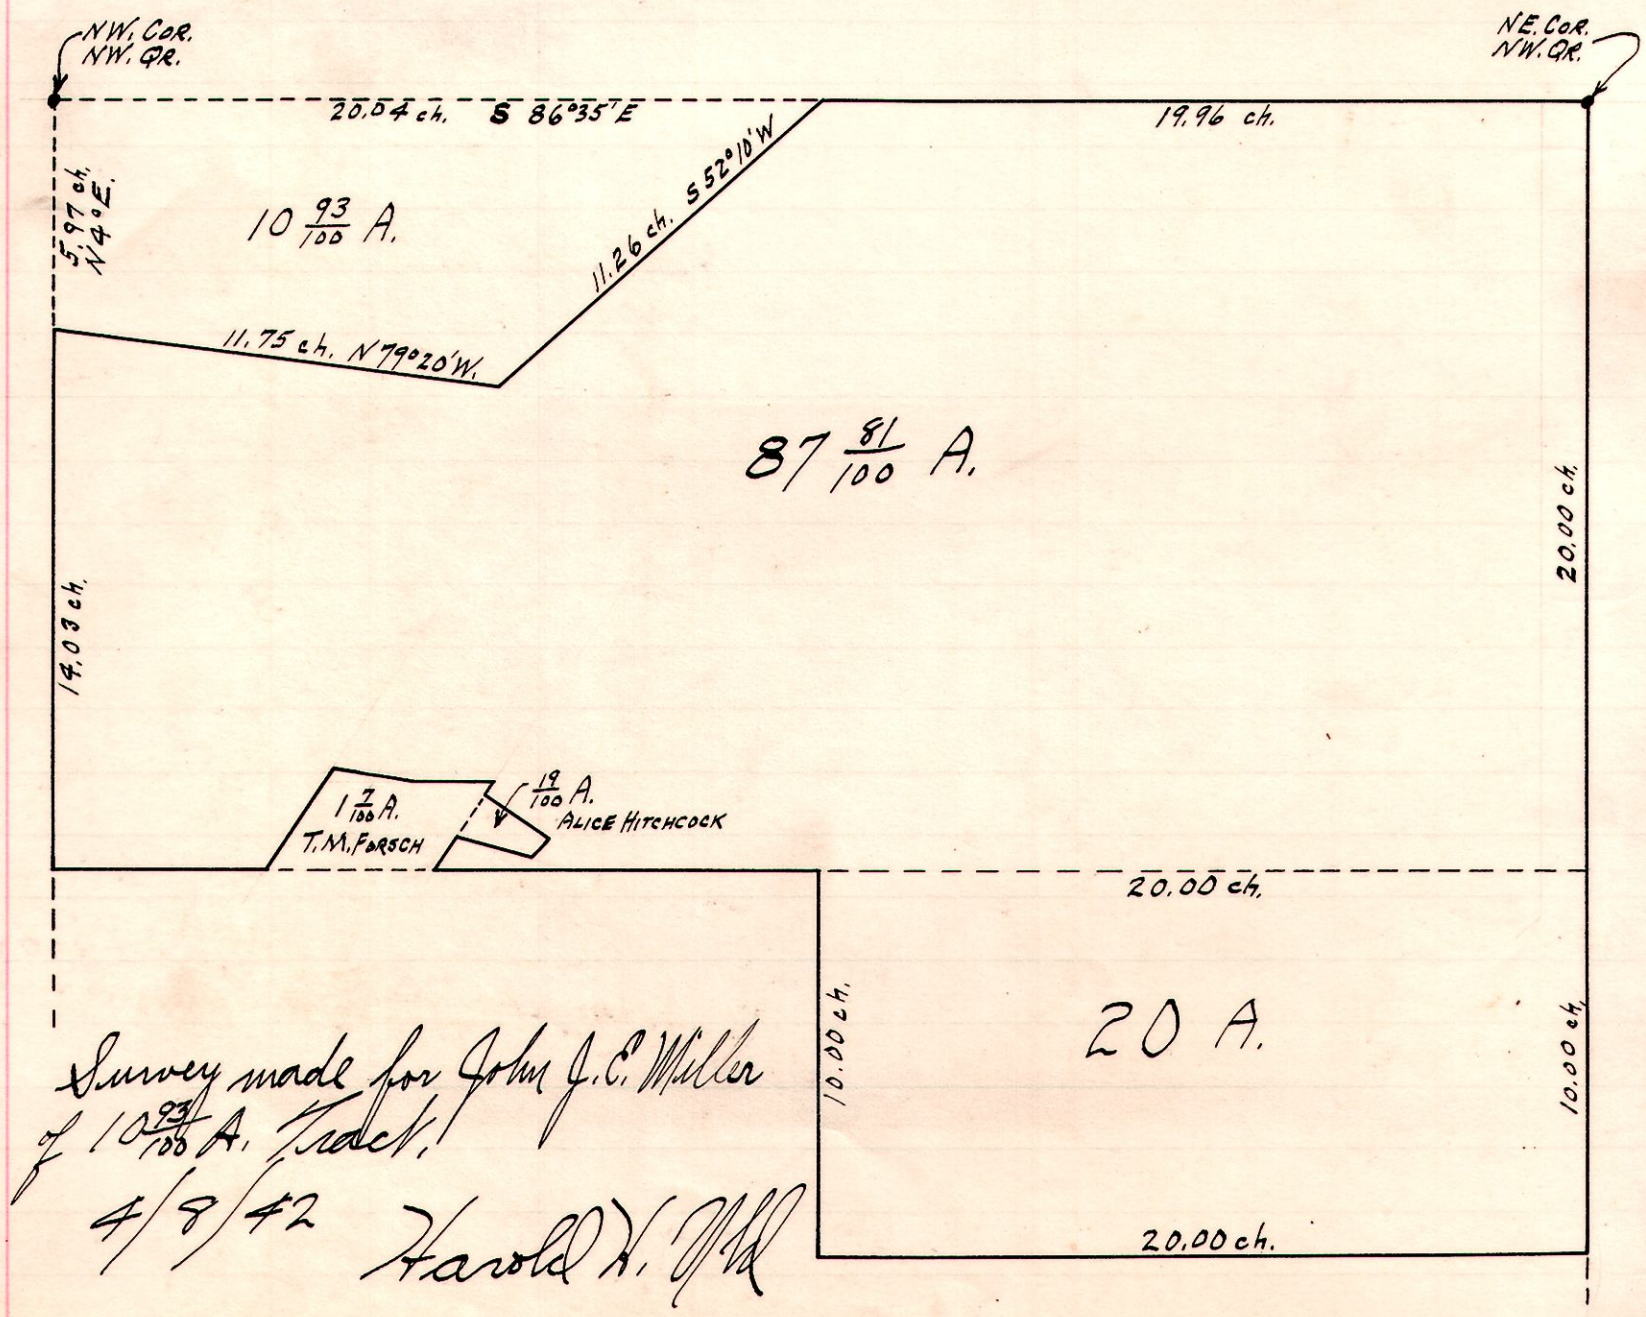

Survey made for John J. C. Miller of 10 93/100 A. Tract.

4/8/42 Harold H. Hill