


66  
66  
126

9  
12 14 9 S.E.  
6 10 6 4<sup>th</sup> Br. Lot 5.

TR 447  
County Road  
Alteration  
Petitioned by  
Sam E. Miller

J. F. Mastrey  
J. E. Martels } Viewers  
L. Rottman } Sworn.

Ben Proyer  
W. L. Reidenbach } Chairman

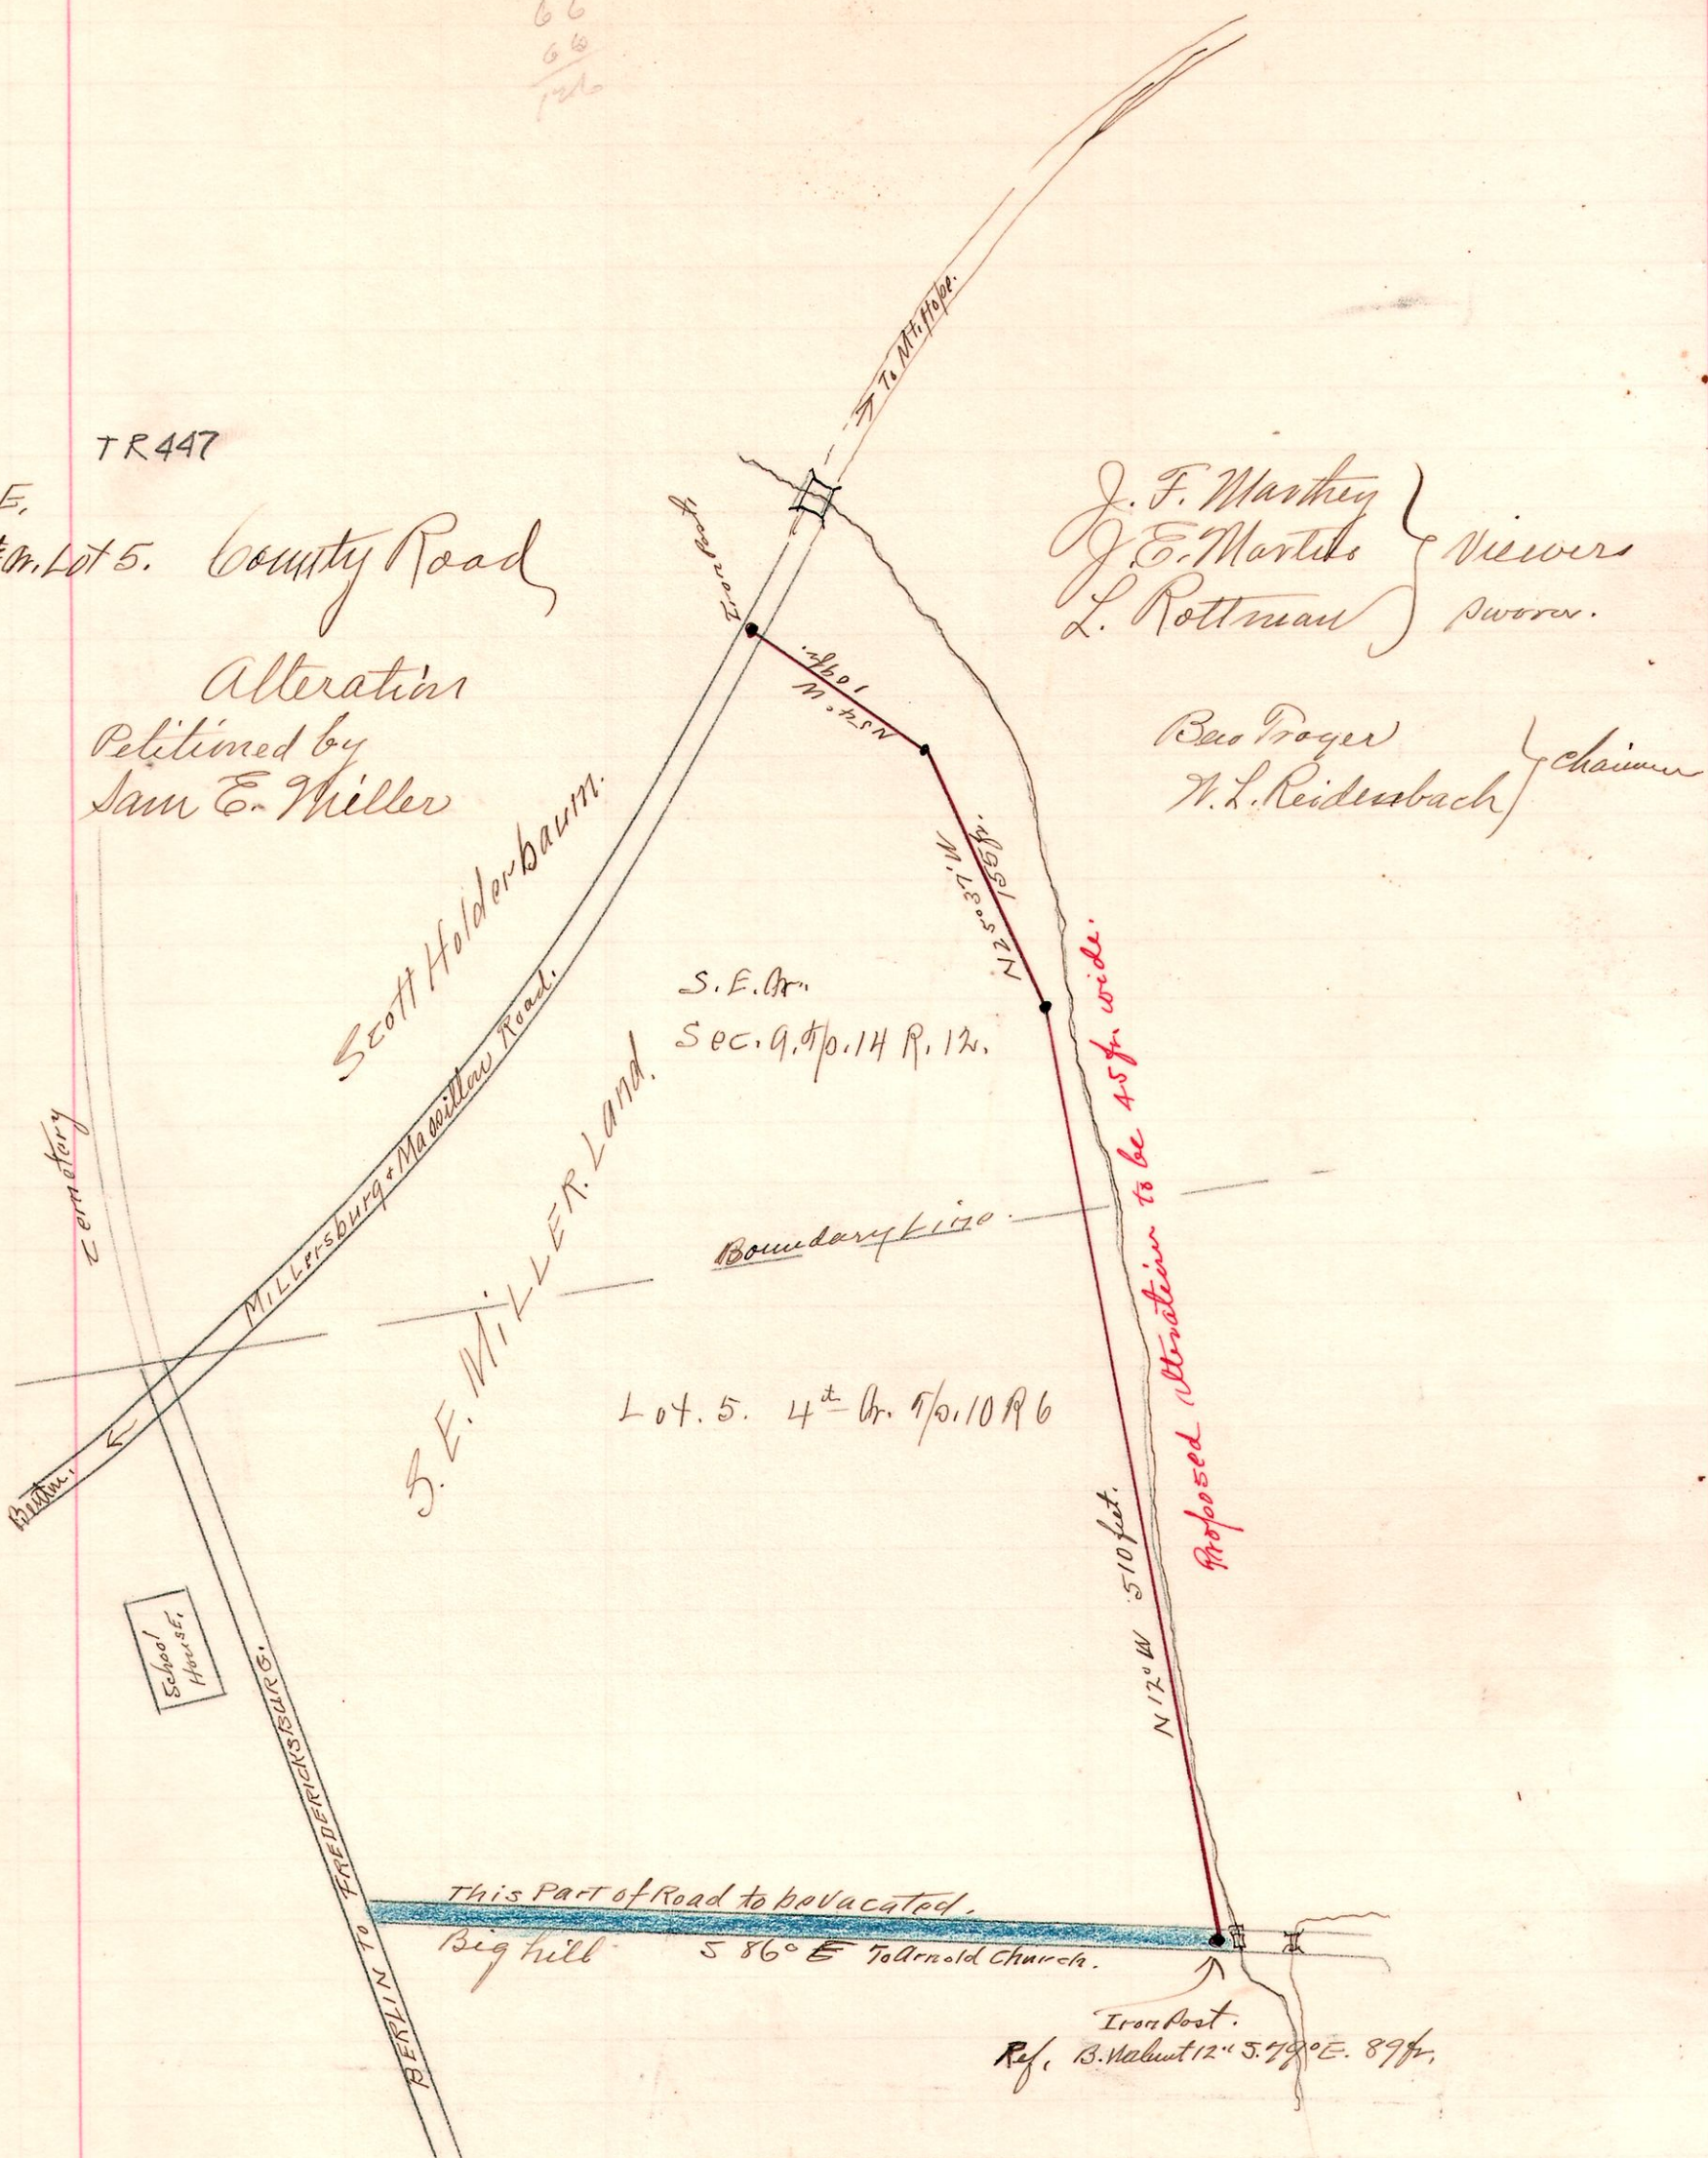

S. E. Qr.  
Sec. 9. Tp. 14 R. 12.

S. E. MILLER LAND.

Lot 5. 4<sup>th</sup> Br. 7/10 10 19 6

Proposed Alteration to be 45 ft wide.

This Part of Road to be vacated.  
Big Hill 5 86° E Tollenold Church.

Iron Post.  
Ref. B. Walnut 12" S. 79° E. 89 ft.

Survey made for alteration of County Road leading from Arnold Church to Freiburg School house in Salter Creek Township. to start at foot of hill and intersect Millersburg & Massillon road east of Scott Holderbaums. Part shown in "Blue" to be vacated.

March 28<sup>th</sup> 1912.

W. L. Reidenbach Co. Surveyor