


R 7, Sec

11 14 2 frac. E 1/2

Survey made for Abraham & Martin Mast.
of E. 1/2 of fract. Sec. 2. T14 R41.

12
12
14.4

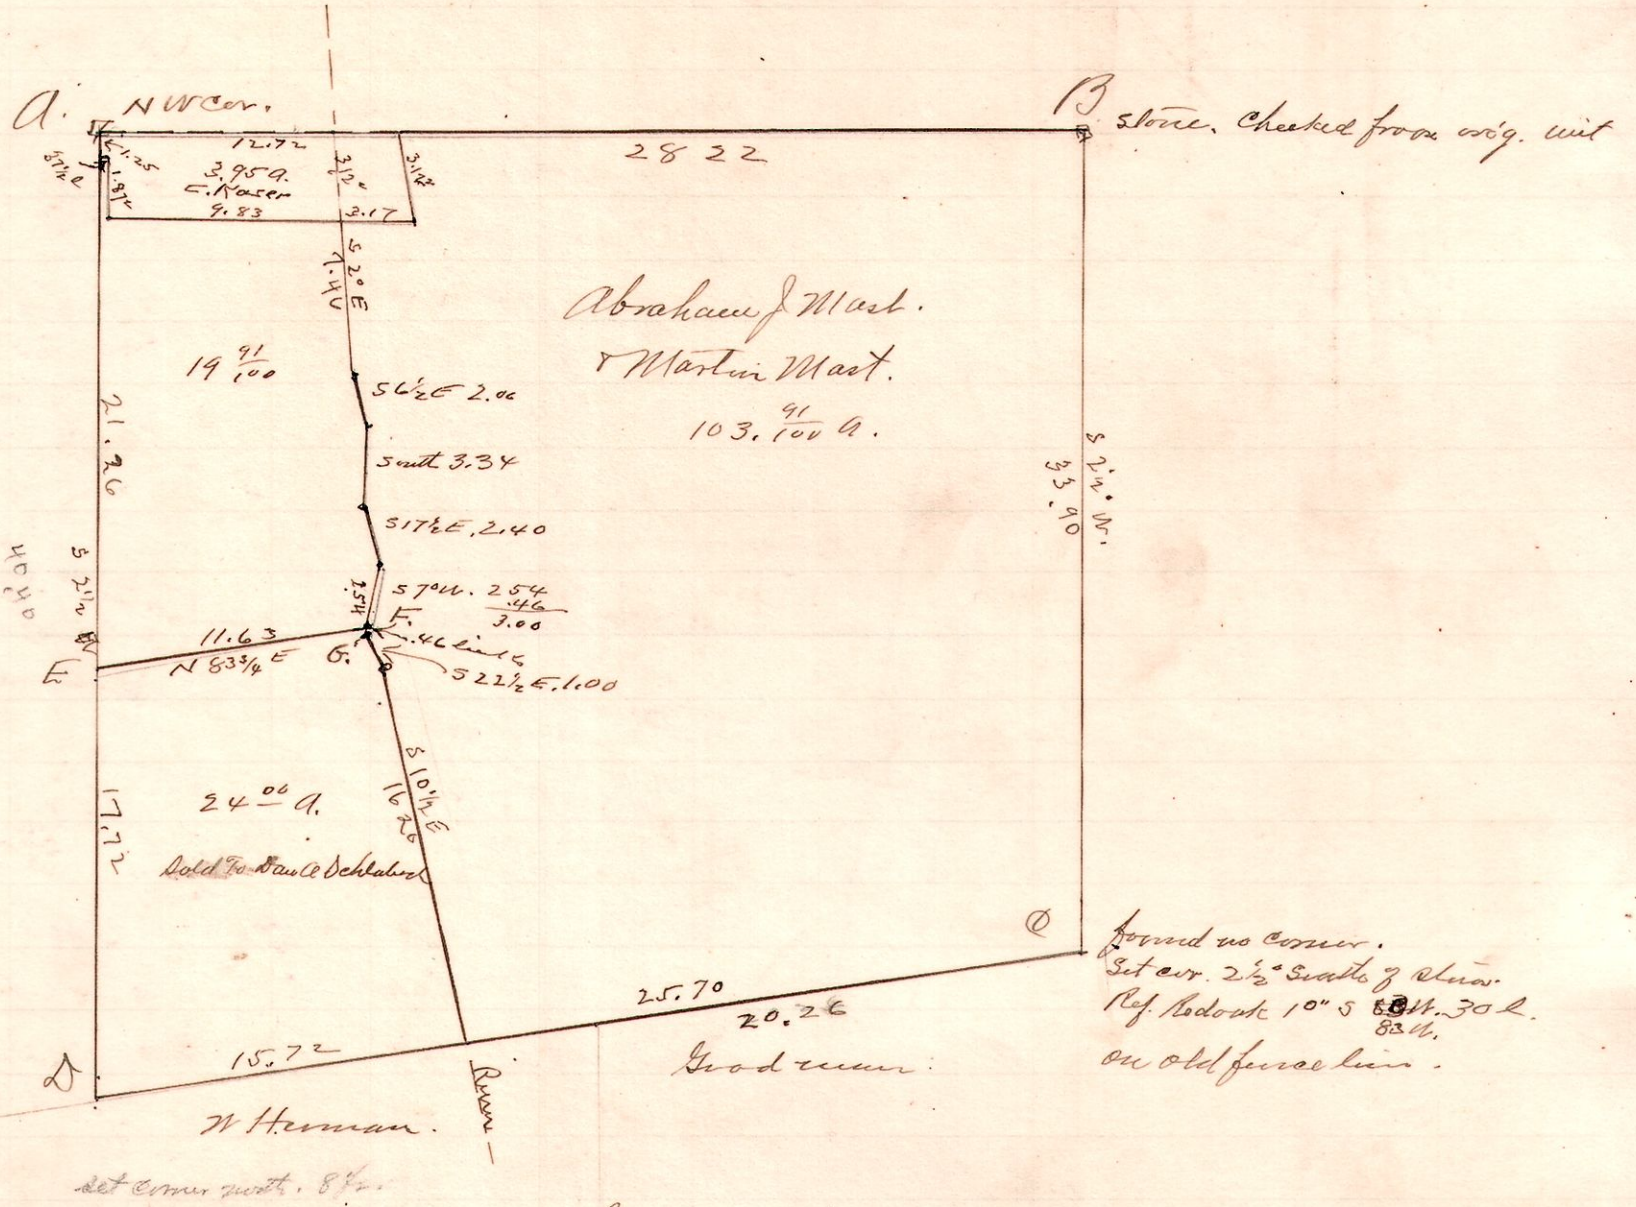

Chairman. W Herman, Amos Mast.
April, 8th 1913.
H. L. Reidubach.