


R T Lot A
7 9 42 1st

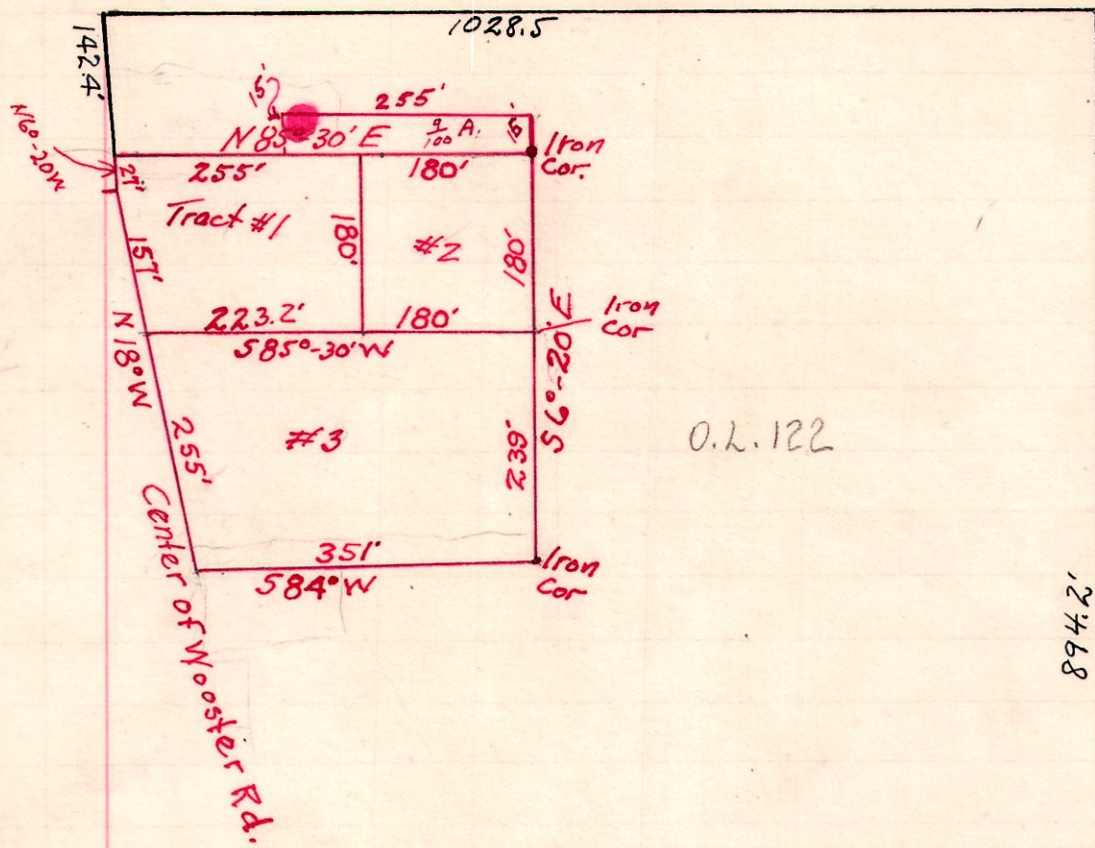

Survey showing Hospital grounds
 Parcel #1 surveyed May 1936
 " #2 " June 1936
 " #3 " Mar 1937

Karl Snyder
 County Engineer

**See Survey
 File**