R. Tp. Se.
13 13 2 N.W.

Survey made for Mel Marquis and Nicholas Yoder to cut off 80 acres.
off the south side of the Northwest Quarter of Section 2. Tp 13. R. 13.
as shown on plat..

Chairman.
Nicholas Yoder.
Wm —

W.L. Reidenbach
Co Surveyor.

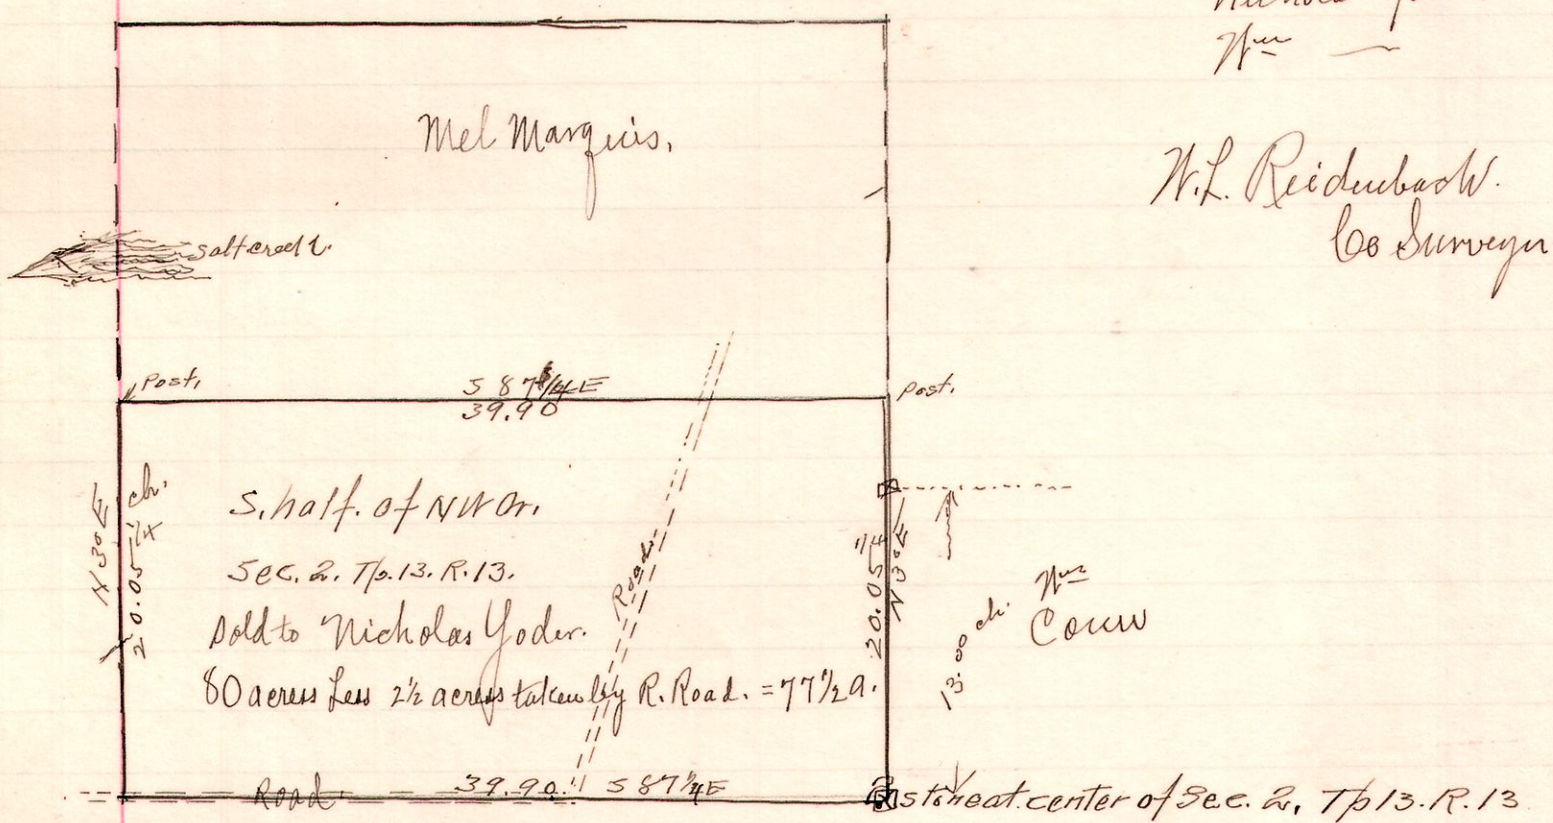

15 19 24 NW. Pt.

Note: — This survey made in accordance with original Deed. Vol. 40 P. 474 and. 494.
Variation from original bearing 2°

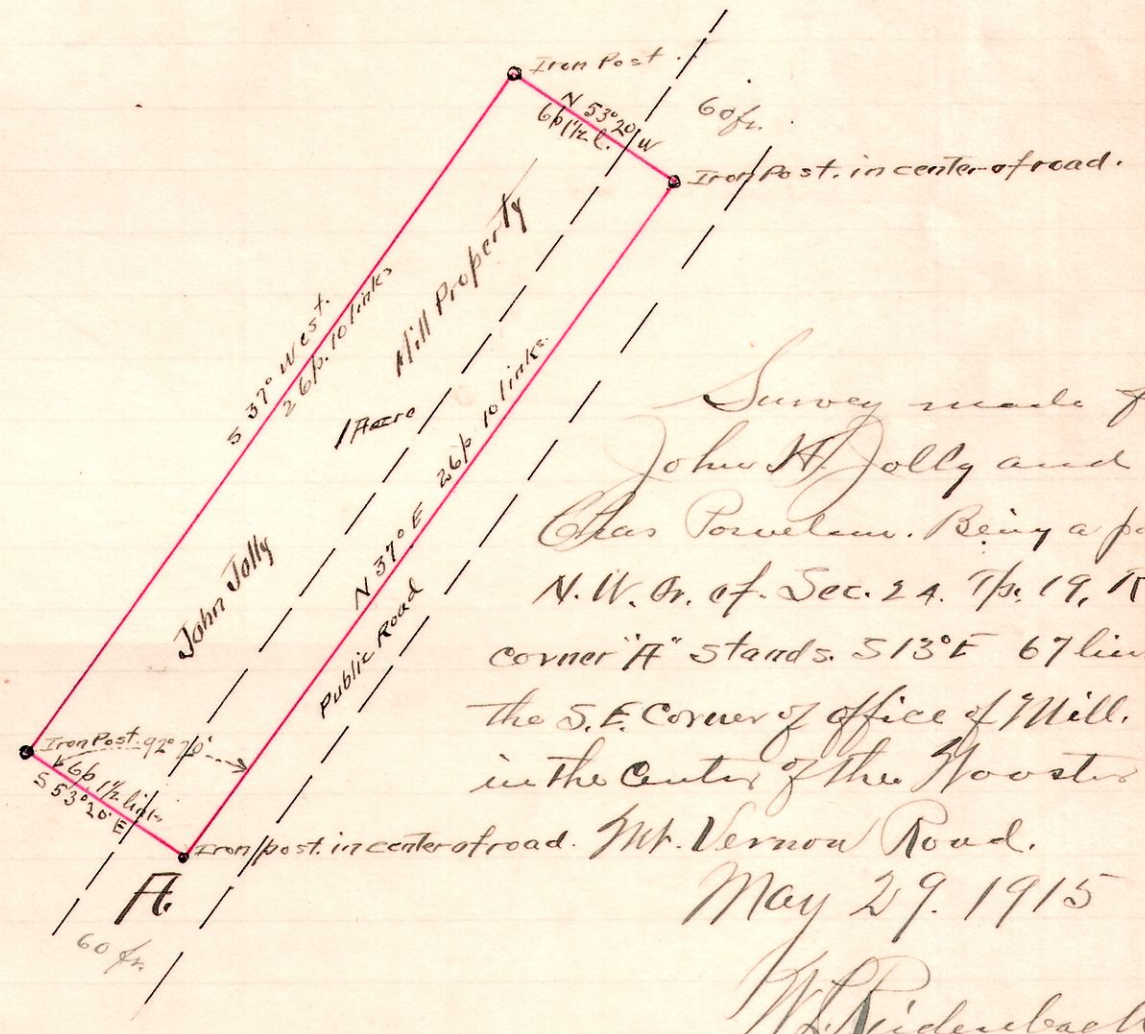

Survey made for
John A Jolly and
Star Powelson. Being a part of the
N. W. Qr. of Sec. 24. Tp. 19. R. 15
the S. E. Corner of office of Mill. and is
in the Center of the Woosters and
Mt. Vernon Road.
May 29. 1915

W. L. Reidenbach
Co. Surveyor.