


SEC. 7 R
35 15 11 SW. PT. OF SE 1/4

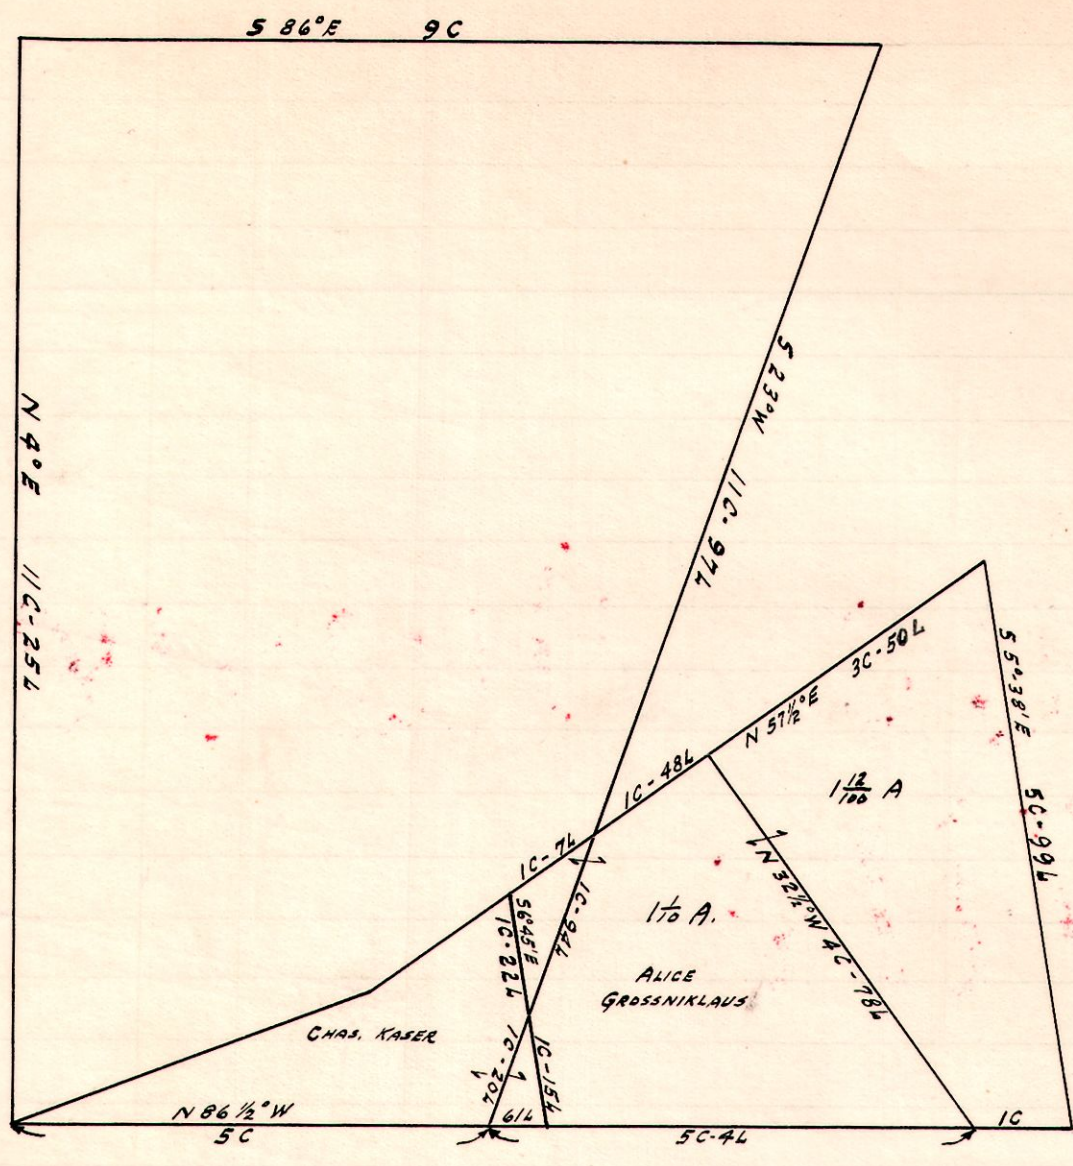

63
7 13 13

