4,8,5. November 7th 1826.
Surveyed Section 5. in Town 8. R. 4.

No 82

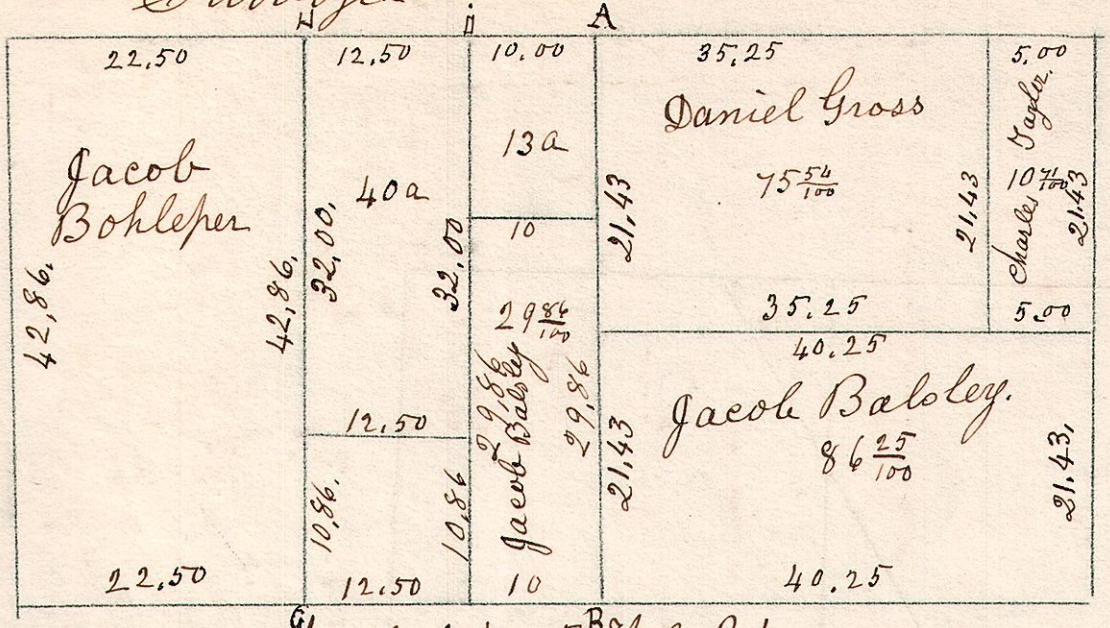

A W.Oak 15 S 44 W 37.
" Hickory 13 S 17 E 12.
B Hickory 15 S 86 W 25
" " 18 S 1 W 40
H W.Oak 10 S 48 E 19
" Hickory 8 S 85 W 22

II W.Oak 3 the corner
"

North half of Sec 5. B Sp 8. R 4.

---

5. 10. 5 & 6. 4th gr. R 5. S 10. lots 5 & 6. 4th gr

No 83

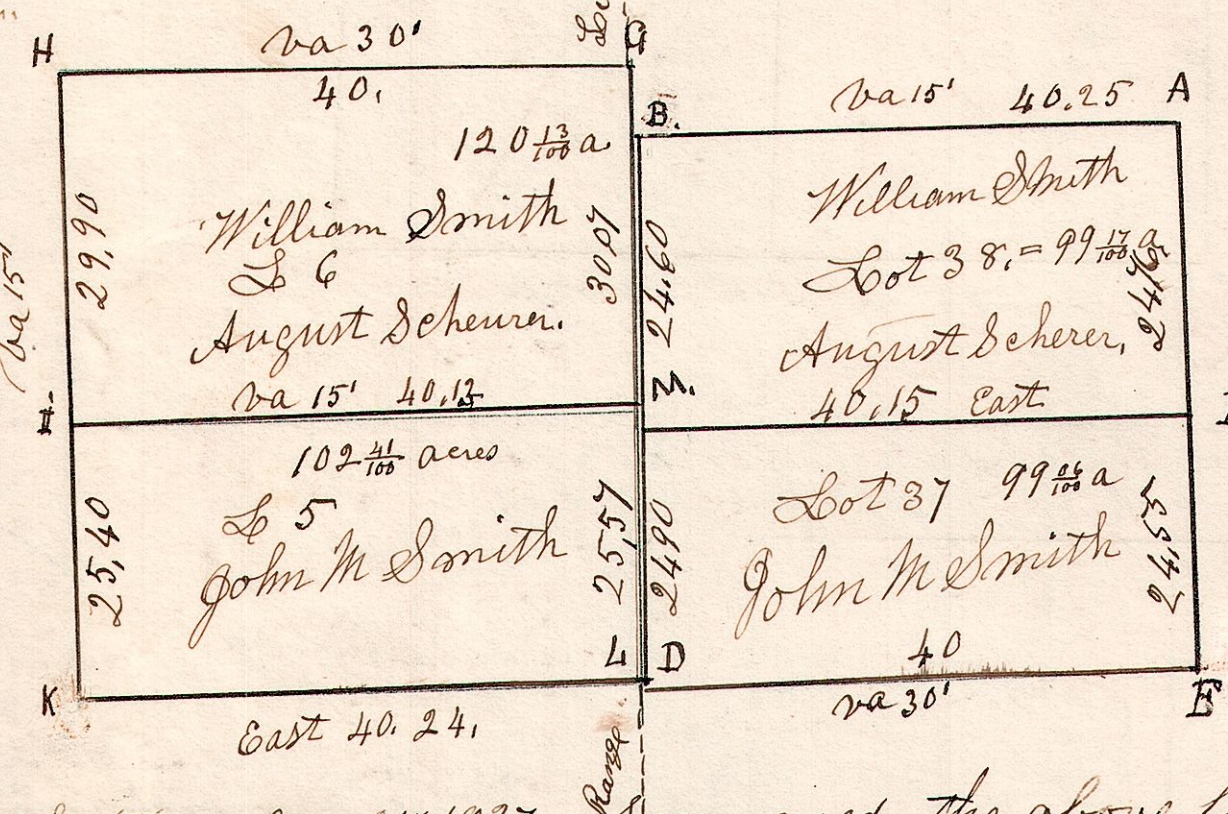

L. Chestnut 30 S 39 E 18.
M. B Oak 18 S 13 W 37½
Poplar 18 N 65 W 27
R. Oak 12 S 64 W 52.

A. 18 W.Oak N 29 E 26.
" 25 B.Oak S 57 W 62
B 10 Lime N 82 E 11
" 12 Gum S 34 E 31
C 15 Hickory N 85 E 37
" 12 B.Oak N 7½ W 13½
D 30 B. Oak East 32½
" 18 do S 2 W 24.
E 15 W Oak N 26 E 14
" 16 B Oak S 64 E 38
F F 15 Hickory N 79 W 15
" 12 Chestnut S 70 E 29
G 15 W Oak S 62 W 23½
" 15 do N 76½ W 17½
H 20 W Oak S 2 W 25
" 15 Poplar N 20 W 2½
I 15 Chestnut S 5 E 24
" 10 do N 78 W 23
K 24 W Oak N 40 E 26
" 9 do S 15 E 34

September 21st 1827. Surveyed the above lots,
Being lots No 37 & 38 in 3d Gr Sp 10 R 4.
And lots 5 & 6. in 4th gr. Sp 10. Range 5.

---

4. 10. 39. 3d gr

No 84 April 6th 1853 Surveyed lot 39.

W. Oak 12 S 55 E 6.7; S 88½° E.
do 11 N 116 20.

Gum & N 81 W 14.
W. Oak 10 N 32 E 47.

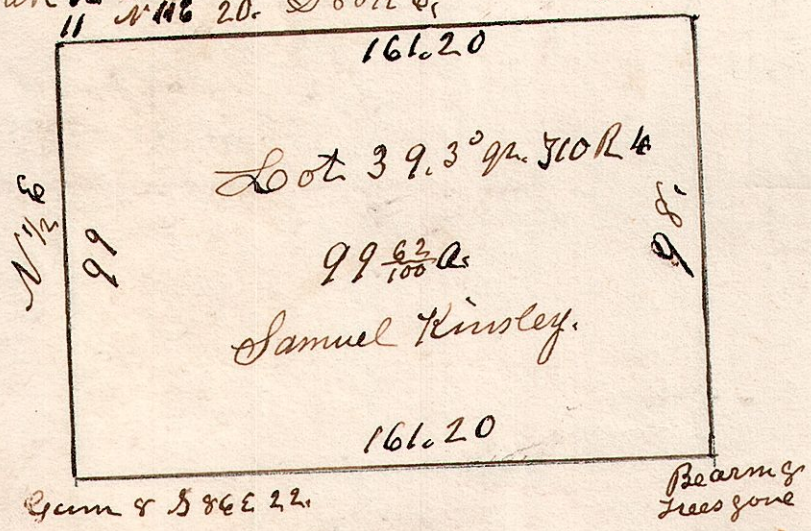

Gum & S 86 E 22.
Bearing Trees gone

4. 10. 25. 3d gr.
No 85

Lot 25. Sp 10. R 4. 3d gr.

N.W. cor.

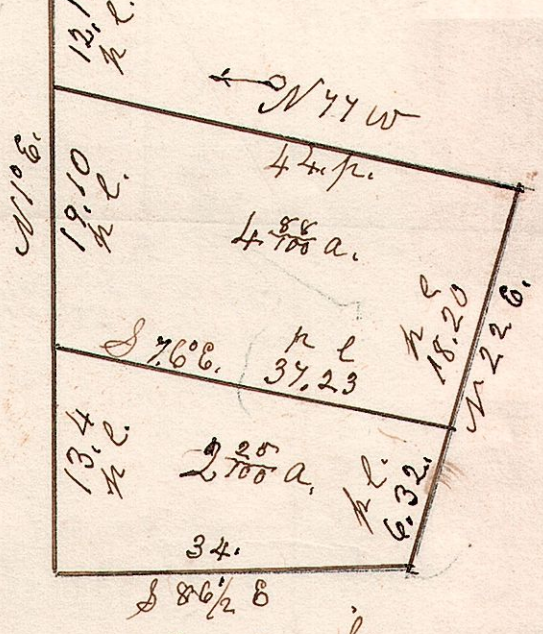

G. Booker.