4.8.5 N½ of Sec 5. T8. R4. Nov 7th 1826.

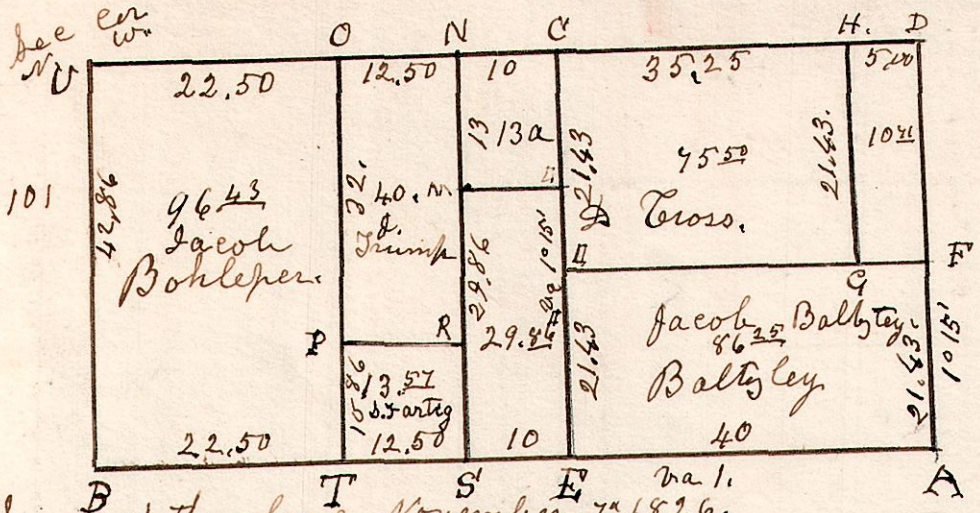

Surveyed the above November 7th 1826, Being the north half of Section No 5, in Township 8. of Range 4. of which the above is a correct plat of the same. Samuel Robinson County Surveyor.

U. See corner.			
A Oak	20	N 4 W	25
" do	22	S 45 W	35
B Chestnut	6	S 88 E	40
" B. Oak	3	N 38 E	16
C W. Oak	15	S 44 W	37
" Hickory	13	S 17 E	12
D Chestnut	50	N 74 E	20
" Hickory	8	N 62 W	29
E Hickory	15	S 86 W	25
" do	18	S 1 W	40
T Hickory	15	S 70 W	66
" Chestnut	20	N 53 W	60
O W Oak	10	S 48 E	19
" Hickory	8	S 85 W	22
F Hickory	9	S 10 W	38
" do	12	N 81 W	26
II Hickory	3	S 60 E	18

Lot 33. Sec 3. T10. R4.

No 102

May 4th 1842.

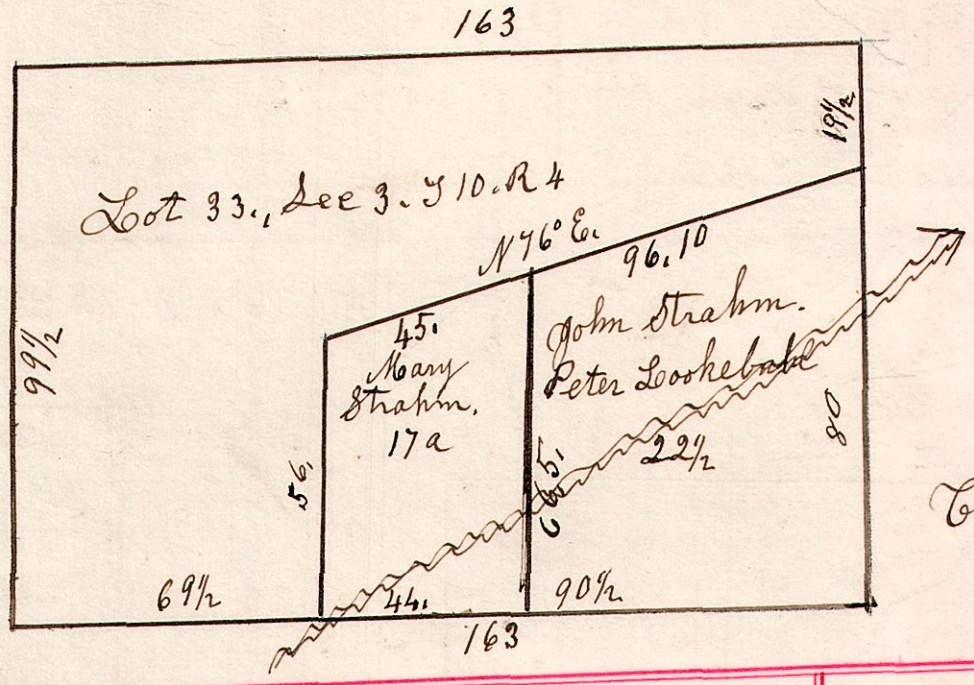

Sham Carnes
Jacob Brumy
John Strahm.

Christian Strahm deceased.

Lot 33 in 3 qr. T 10. R4.
4. 10. 33. 3½ June 22 1841.

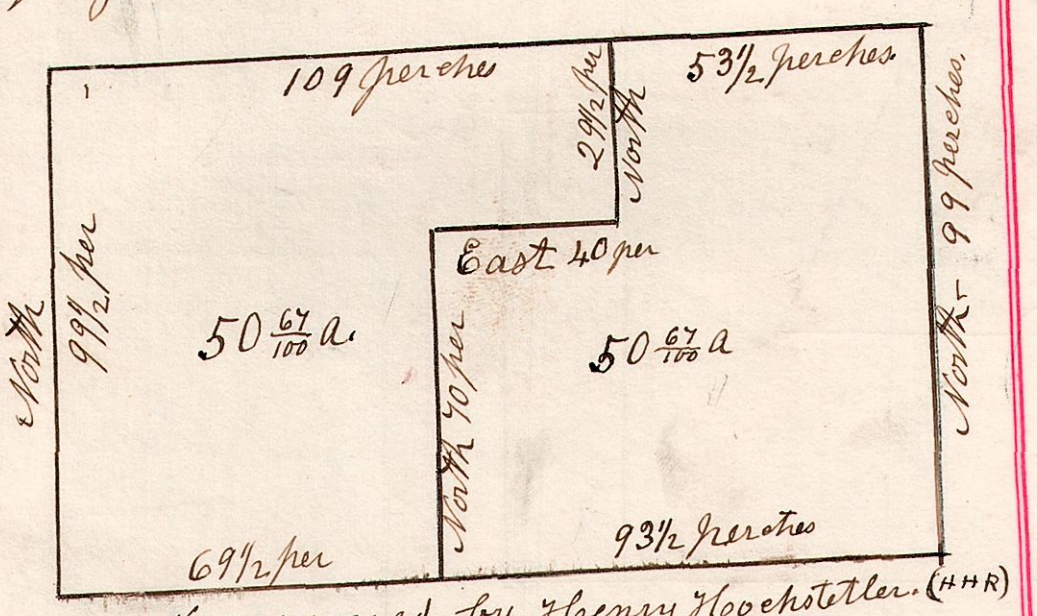

4. 9. 16.

No 105

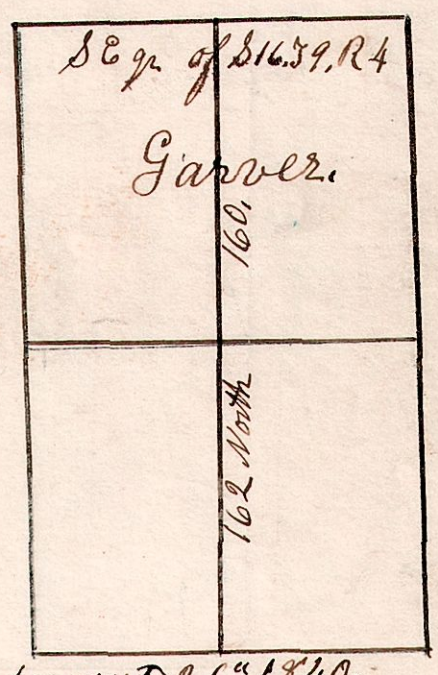

August 26th 1840.
Surveyed the division line N & S through through the above two quarter Sections
The line on the south side of the N E qr of Sec 25 being surveyed by Wampler & some other Surveyor and from its appearance I think it is not correct. S. R.

The above was Surveyed for Wm Garner & others.

4. 9. 24. SW qr. of Sec 24, T 9. R4.

SE qr of Sec 24. T 9. R4.

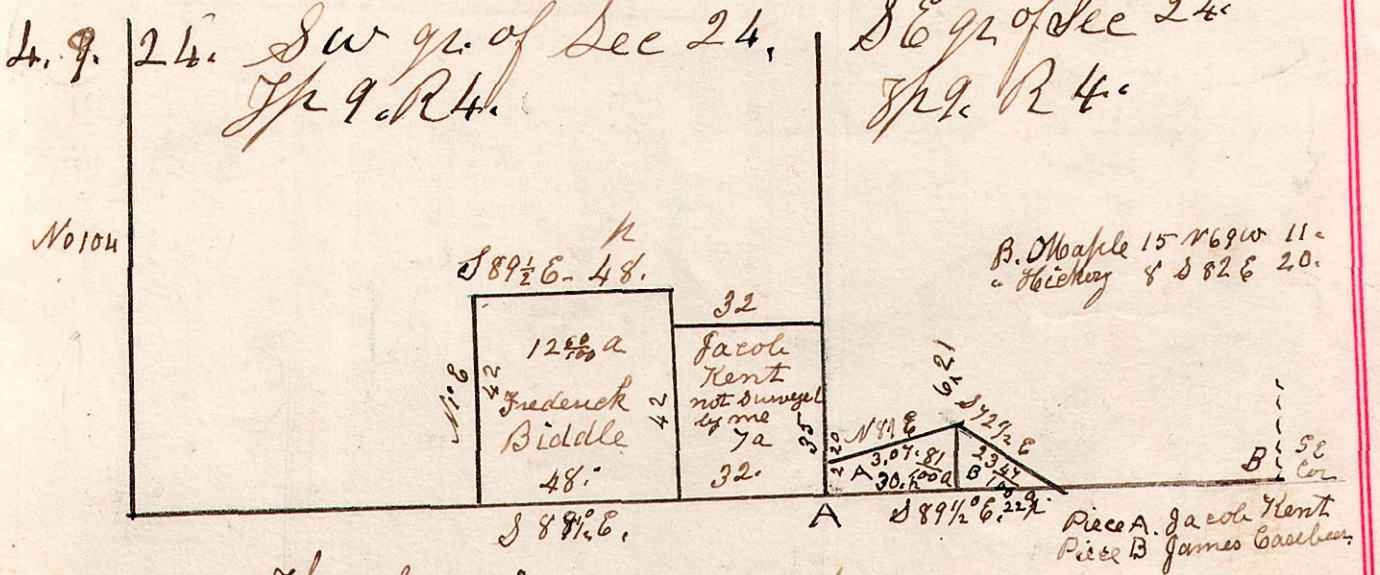

The above Survey made for Benjamin Hochstetler Nov 11. 1853.

A Chestnut 13 N 57 W 18.
B. Oak 36. East 26.