


5. 10. 27. 4th q^r.
 September 22^d 1827. Surveyed lot No 27 in the
 1st quarter of the 10th Township of the 5th Range,
 in the following manner
 and for the following persons.

No 123

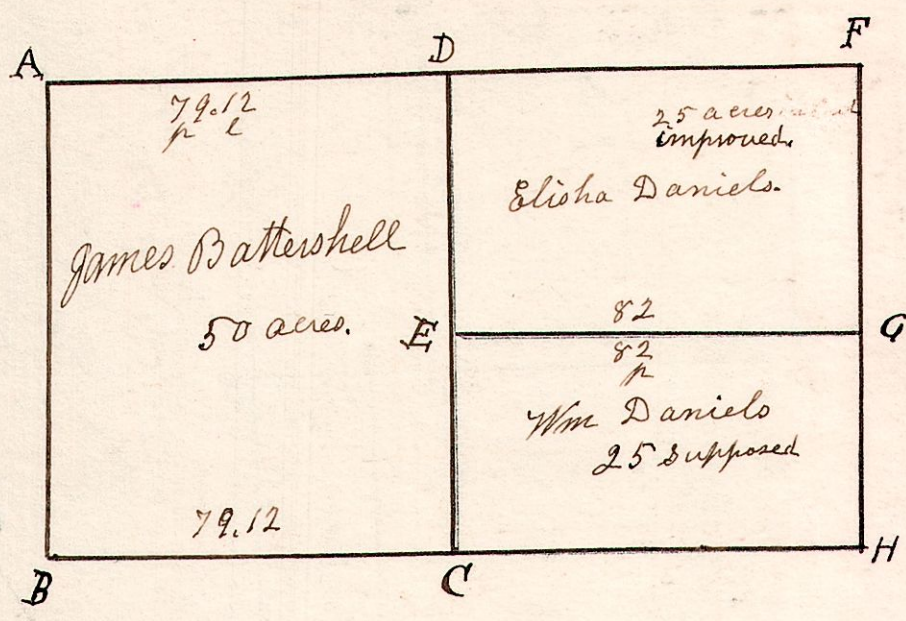



5. 10. 1/2 4th q^r.

April 18th 1829.
 Surveyed Lot No 12, in the 4th q^r
 of the 10th Township of Range 5.

No 124

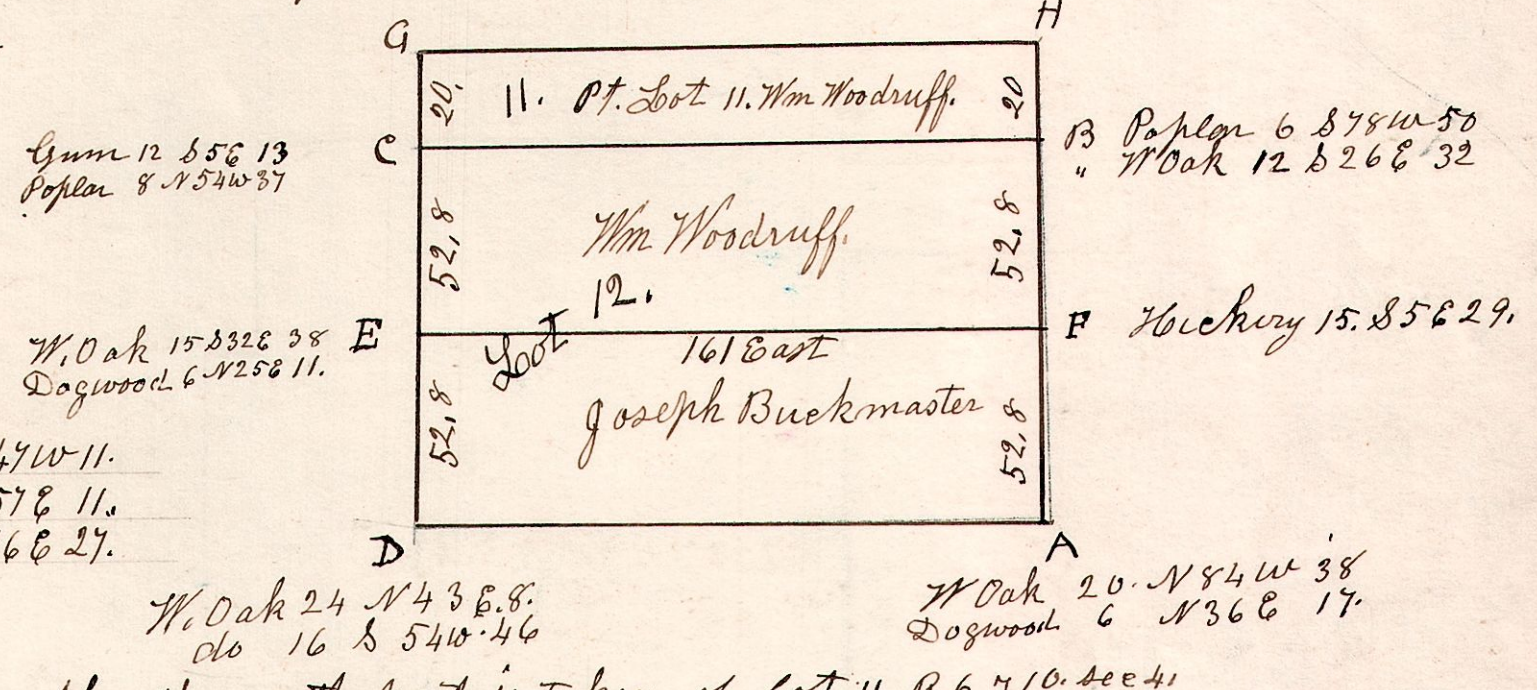

Also the north part is taken of lot 11, R 6, T 10. See 41

5. 10. 23. 4th q^r.

May 8th 1865.

No 125

