


5. 9. 19. N.E.

N.E. q. of Sec 19. T. 9. R. 5. ne.
April 24th 1861.


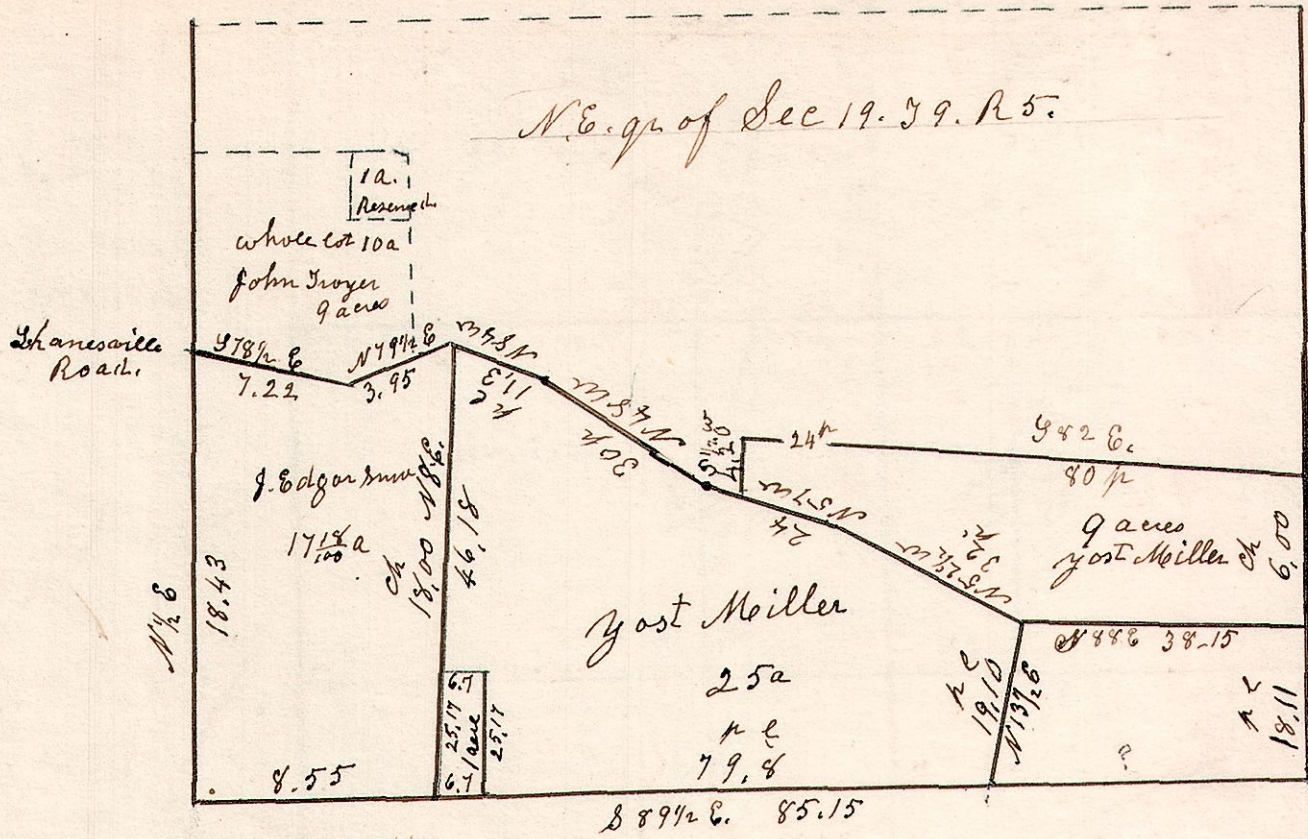


5. 9. 13. 1st gr. Lot 13. 1st gr. T. 9. R. 5.
Also Lot 18. 1st gr. T. 9. R. 5.

5. 9. 13. 18. 1st gr. May 9th 1871.


No 173

November 12th 1856.

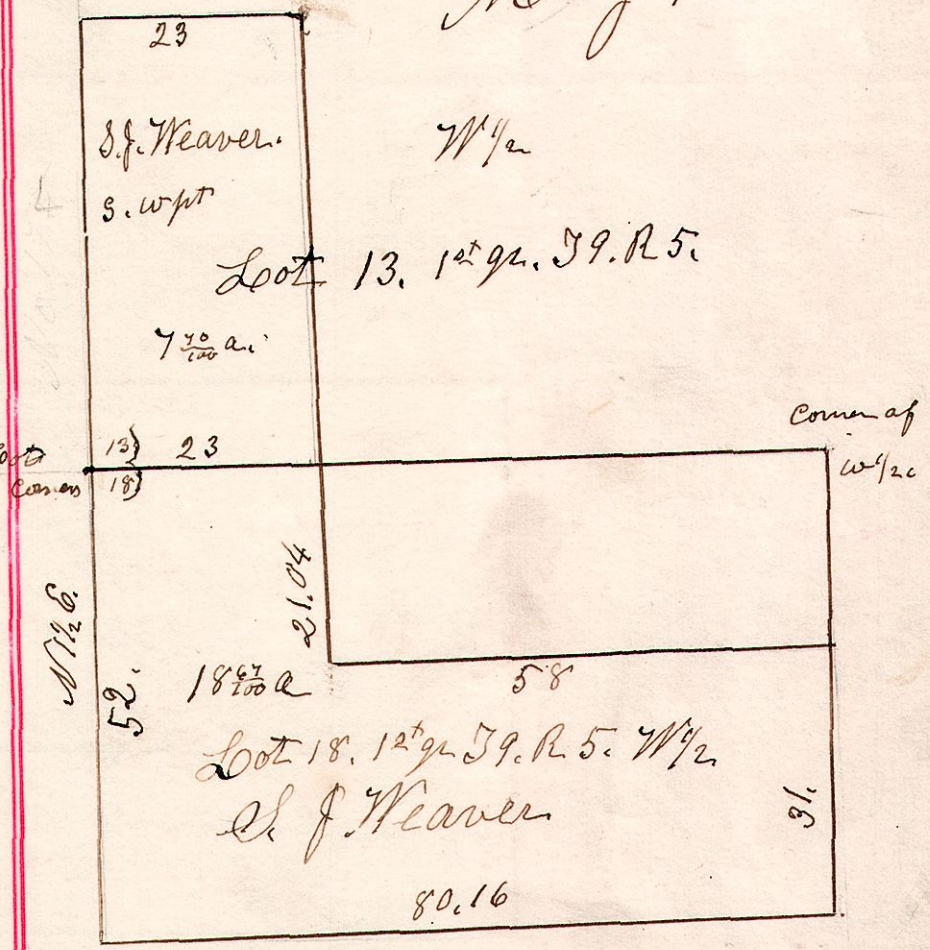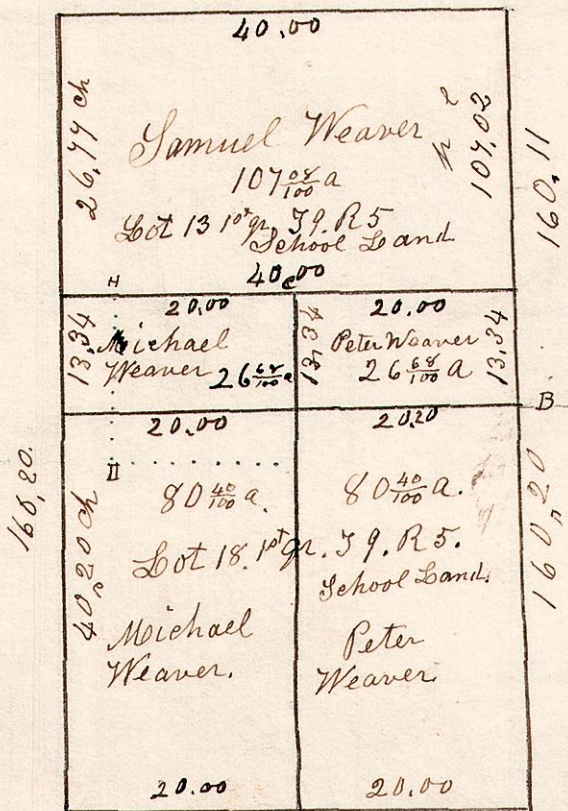


5. 9. 26. 3rd gr.

5. 9. 31. 2nd gr.

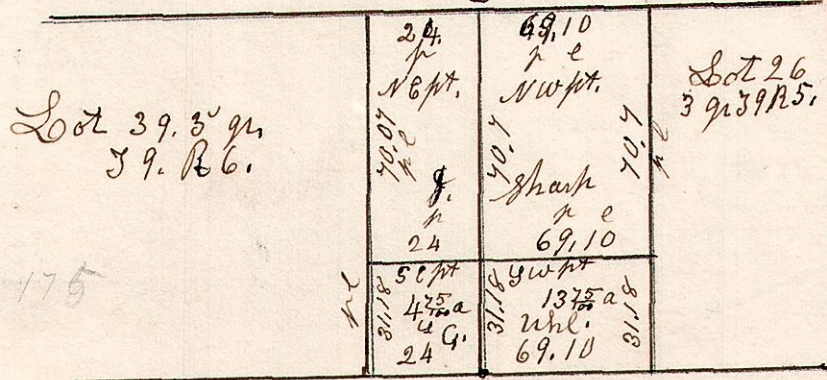

Lot 31. 3rd gr. T. 9. R. 5.

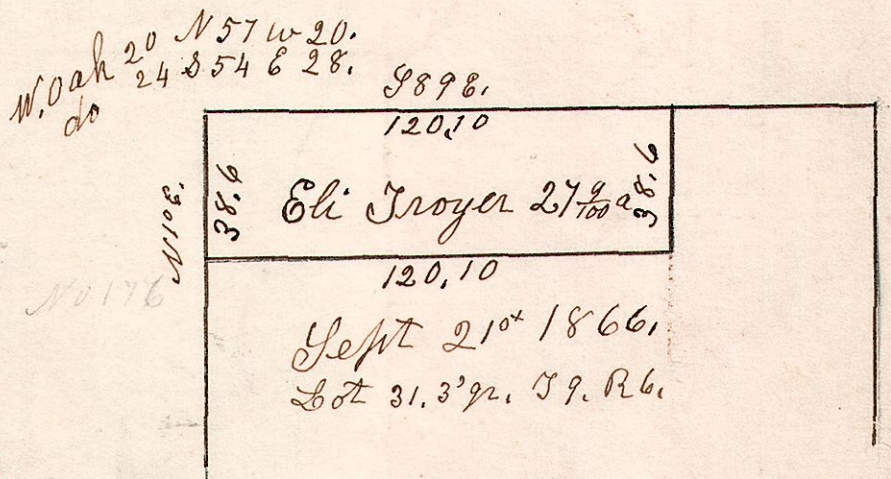

A. corner between lots 26 & 39.
B. " " " "