


5. 9. 3rd gr. Lots. 25, 26, 27, 38, 39, 40.

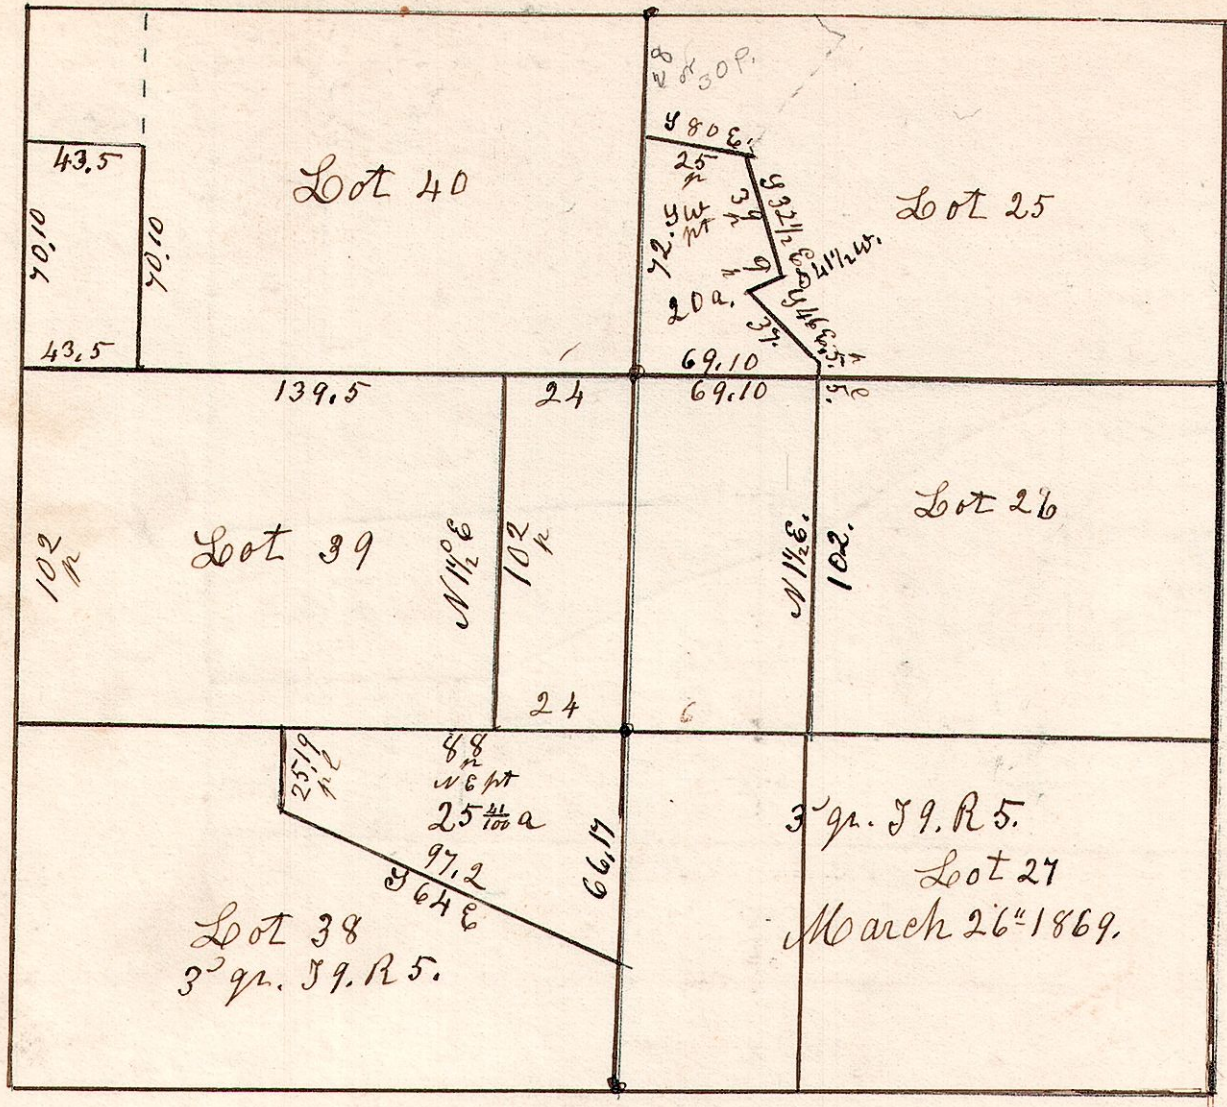


John Sharp
Survey
March 26th 1869.

5. 9. 17. 3rd gr.

Lot 17. 3rd gr. T9. R5.
Sept 21st 1866.

W Oak 24 S 55 W 30.
do 18 N 68 E 31.

Hickory 18 S 47 W 100.
Chestnut 18 N 57 E 22.

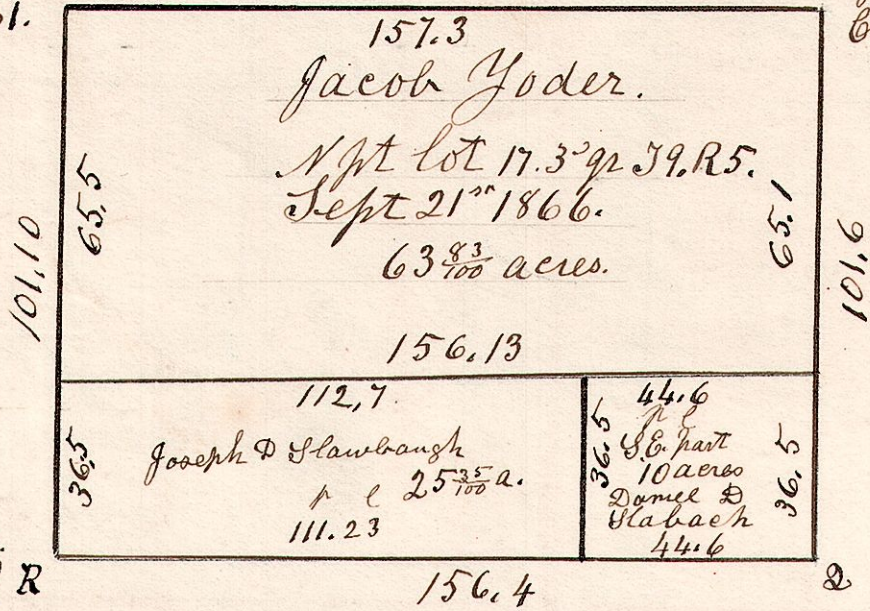

Hickory 24 N 2 W 10.
W. Oak 40 S 80 E 49 R

Maple 12 S 38 W 5.
Hickory 20 N 39 E 36.

5. 9. 6. 1st gr.

May 8th 1849. Surveyed Lot 6. 1st gr. T9 R5

