


November 8th 1831 Surveyed Section 21 in T9, of Range 5
 in the following manner and for the following persons.

5. 9. 21.

Hickory 15 North 26 1/2
 W. Oak 16 S 78 E 13

W Oak 18 S 55 E 50.
 do 18 S 82 E 50.

Cherry 5 N 40 E 37
 W. Oak 24 S 32 W 58.

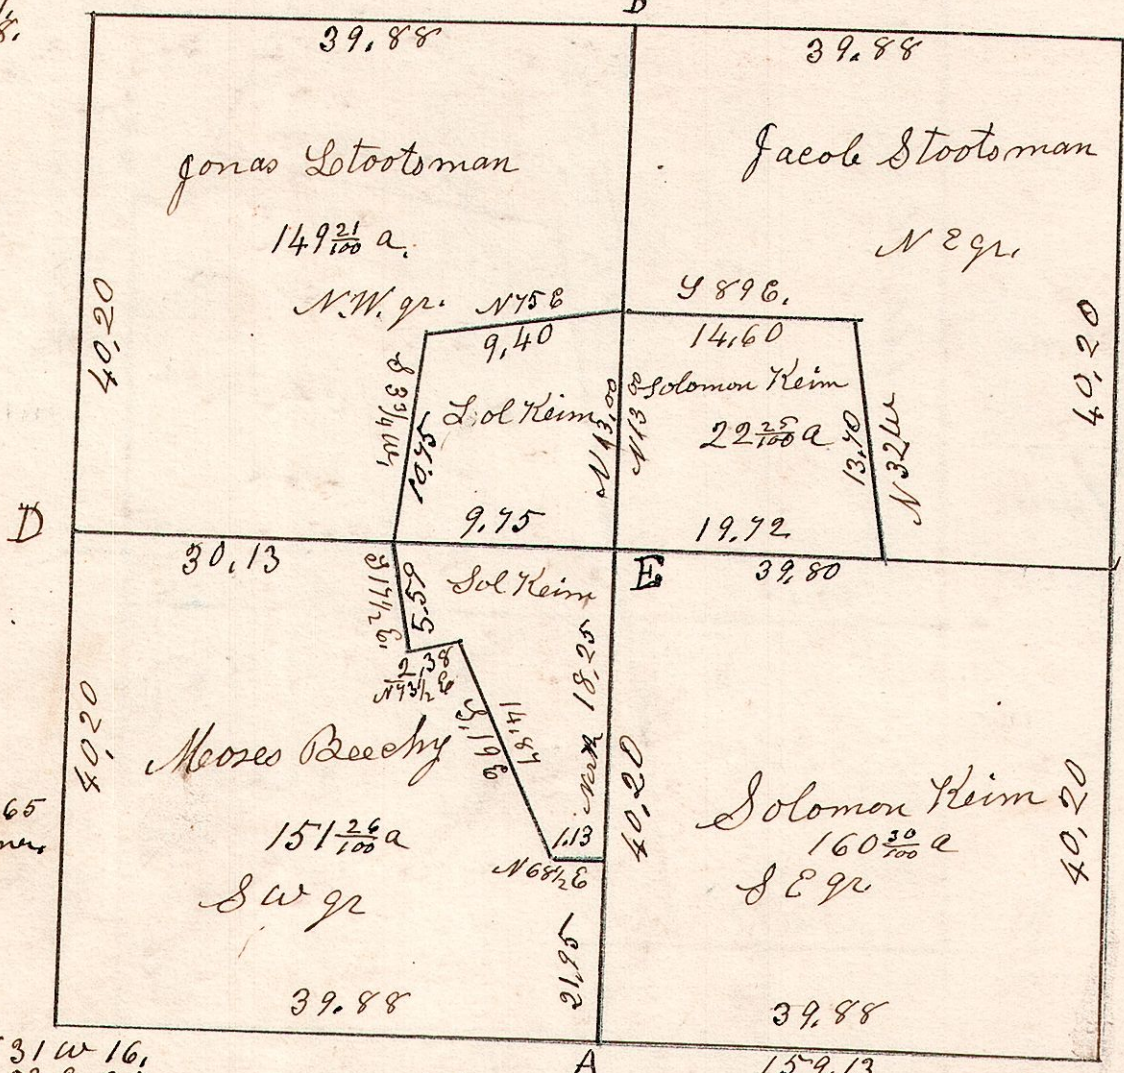

W Oak 10 N 31 W 47
 S. W. Oak 6 N 38 W 57.

W Oak 22 S 55 E 43
 do 25 N 66 W 49.


E Sugar 18 S 52 E 65
 + stone 12" the corner

W. Oak 30 N 31 W 16,
 do 12 N 63 E 25.

Hickory 10 N 1 W 42, Hickory 18 N 2 W 49,
 W. Oak 12 S 24 E 6, do 12 S 44 W 72.

So all the corners around the 3 pieces in the center of see is stone corners.

5. 9. 21

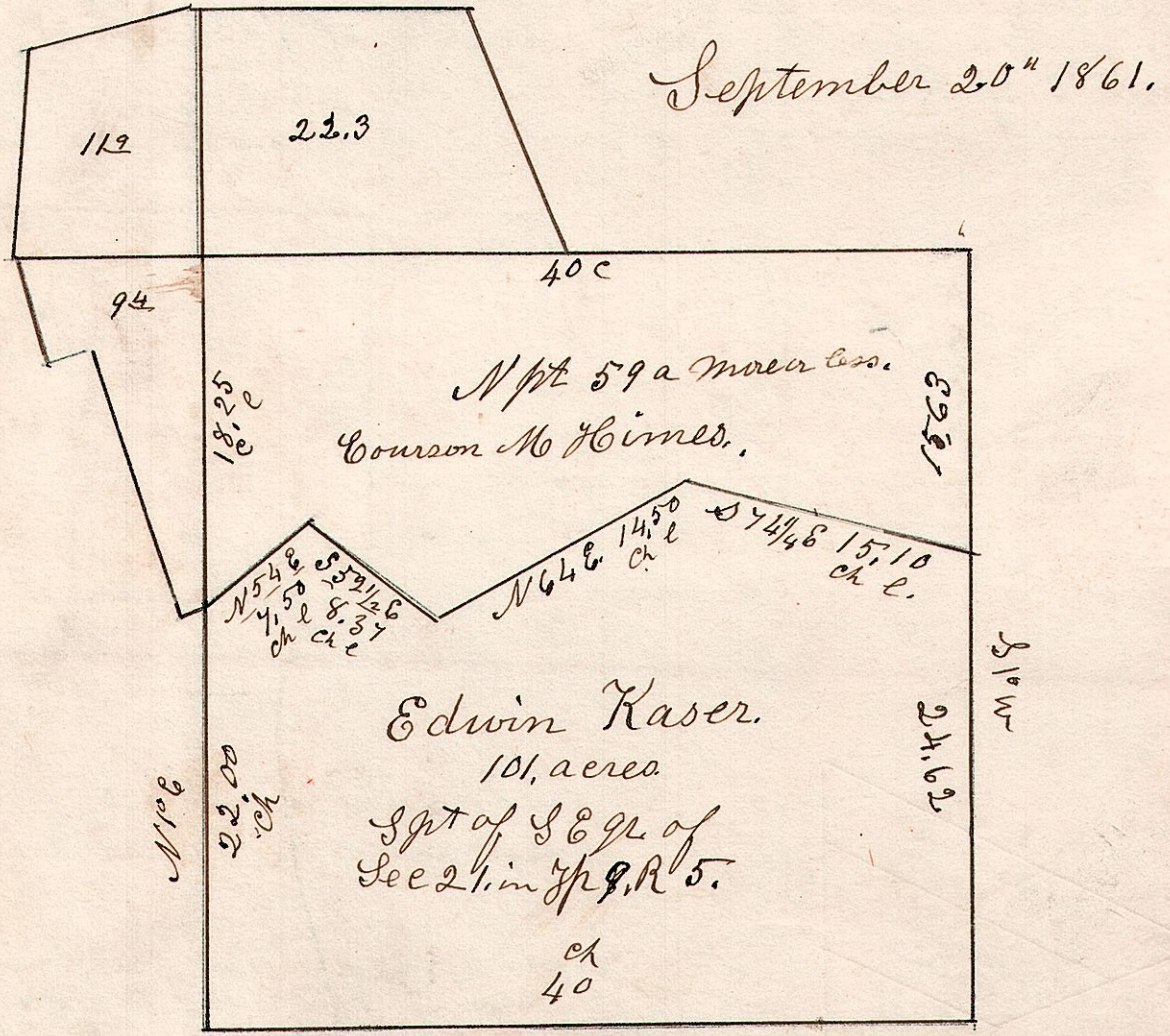

Quit claim Deed to be written from Courson McHines & Frances his wife
 and Elisabeth Kaser, to Edwin Kaser for 101 a. Spt. Considered \$2750.
 One from Edwin Kaser & Barbara his wife to Courson McHines for the
 3 Small pieces + Npt of q sec 59 a) all 101 a. less Corn 1/4 of \$3500.