


April 3-1827

7.9.24th Lot 24, 1st gr. T9, R7.


572

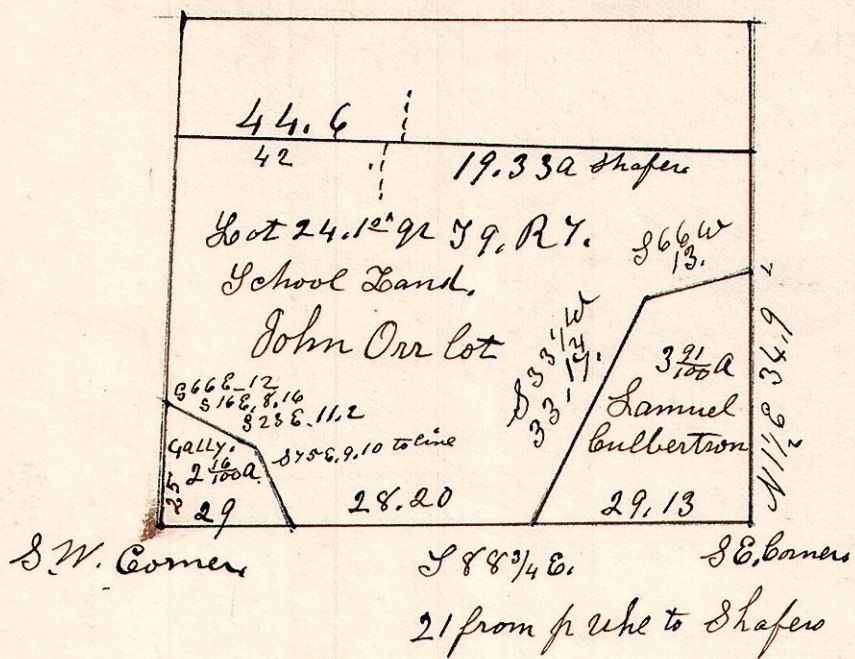

7.9.21. 1st gr.

April 14th 1838. Lot 21. in 1st gr. T9, R7.

- A South 37
 - B S 86 E 34
 - C N 40 E 23 nearly to saw mill
 - D S 84 E 46
 - E S 47 1/2 E 30
 - F S 33 E 14
 - G S 57 1/2 E 37.7 to line
- From S E corner to post,
N 57 3/4 E

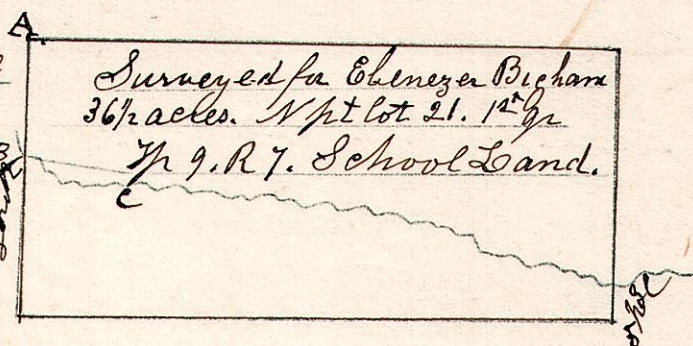


7.9.30. 1st gr.

Dec 28th 1867

Lot 30 1st gr. T9, R7 School Land

574

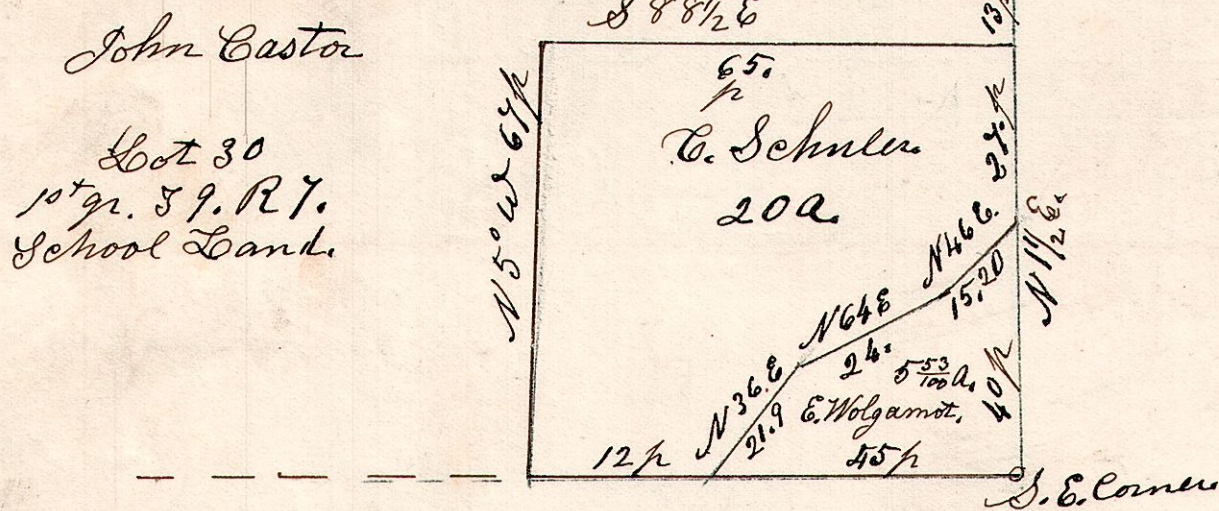


7.9.7.3rd gr.

Lot No 7. in 1st gr. in T9 of R7.

W. Dak 6. S 36 3/4 W. 14. Beech 5. S 16 3/4 E 22.

Beech 2. N 25 E 13. Beech 7. S 40 E 15

Chain Carriers
 Samuel Farra
 Robert Howard
 Marker.
 Wilson Purnoy

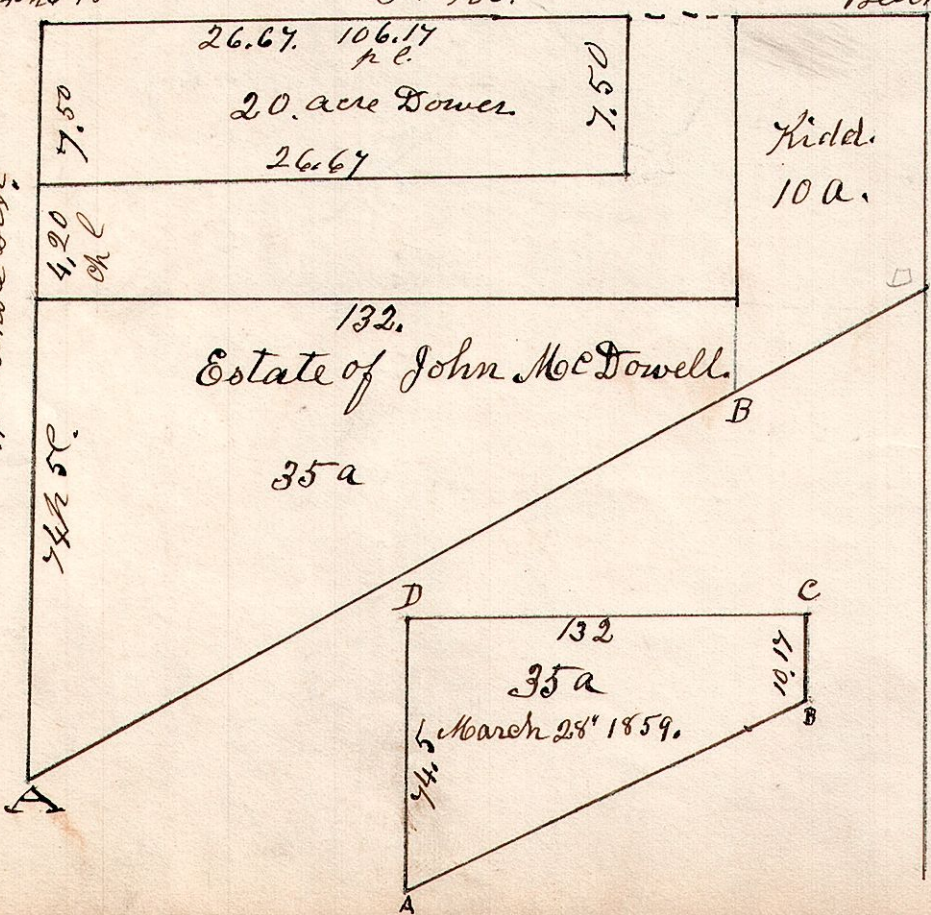

Whole Distance 39.60 ch. E.