T. 10. 8. 4th qr

April 7th 1871.

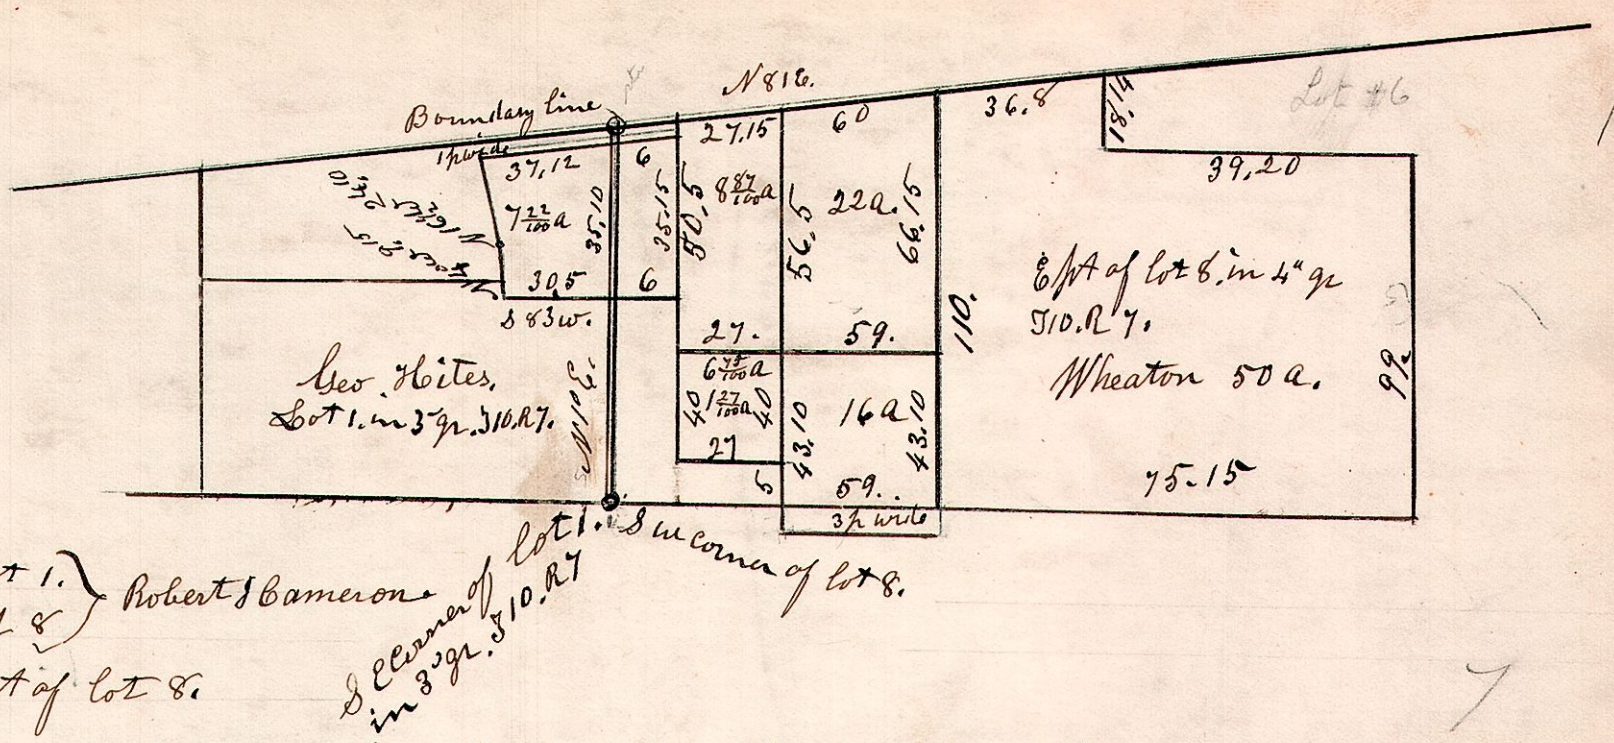

7 22/100 Acres N E pt lot 1.
1 27/100 " N W pt lot 8. } Robert S Cameron

6 75/100 acre piece pt of lot 8.

1 10/100 acre piece, the 3 perch strip, pt of Sub lot 2, of lot 4. Valentine Hites.
Com 55 perch W, of N E cor. of Sub Div lot 2, of lot No 4.
April 7th 1871.

T. 10. 8. 4th qr.

May 22d 1879. Lot 8. in 4th qr T10. R 7.

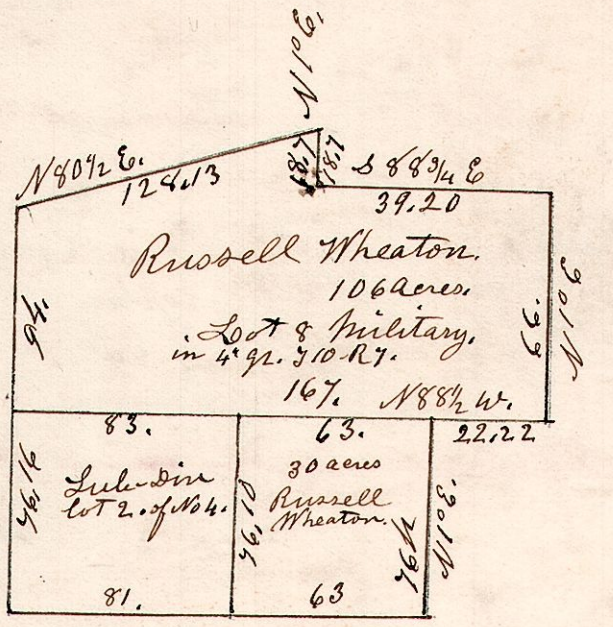

May 2d 1849.

Witness Trees mostly gone, Stone planted at the corners.

Surveyed for Russell Wheaton, 30 acres East End of Sub-Div lot 2. of No 4. Military lot 8. in the 4th qr. T10 R 7.

T. 10. 8. 4th qr.

S June 13th 1829.

Surveyed Lot 8. T10. R 7. 4th qr. in the following manner and for the following persons.

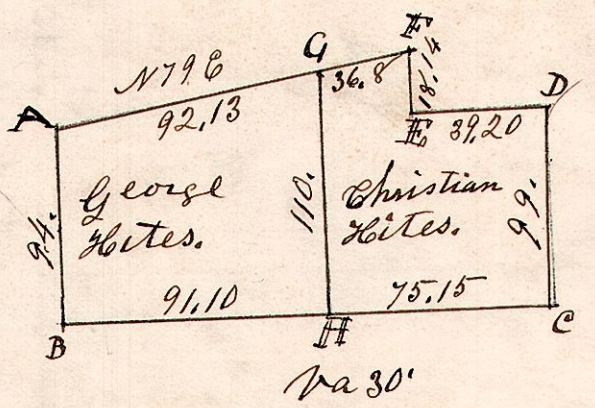

Via 30'

A. Stone Corner
B. B Oak 15. N 79 E 11.
C. Elm 10 N 8 E 13.
W. Oak 6 N 80 W 10.
D Beech 18 N 57 E 14.
" Do 18 S 40 E 24.
E W. Oak 24 S 16 W 10.
" Elm 12 N 10 E 29.
F B. Oak 15 N 79 W 17.
" W. Oak 5 S 67 W 20.
G B. Oak 12 N 75 W 17. W Oak 15 N 15 E 20 1/2.
" Do 5 S 53 W 11.
H Poplar 20 North 39.
" Chestnut 3 S 10 E 13.