


7.9.7^{1/2}

Surveyed what is known as Beards Island.

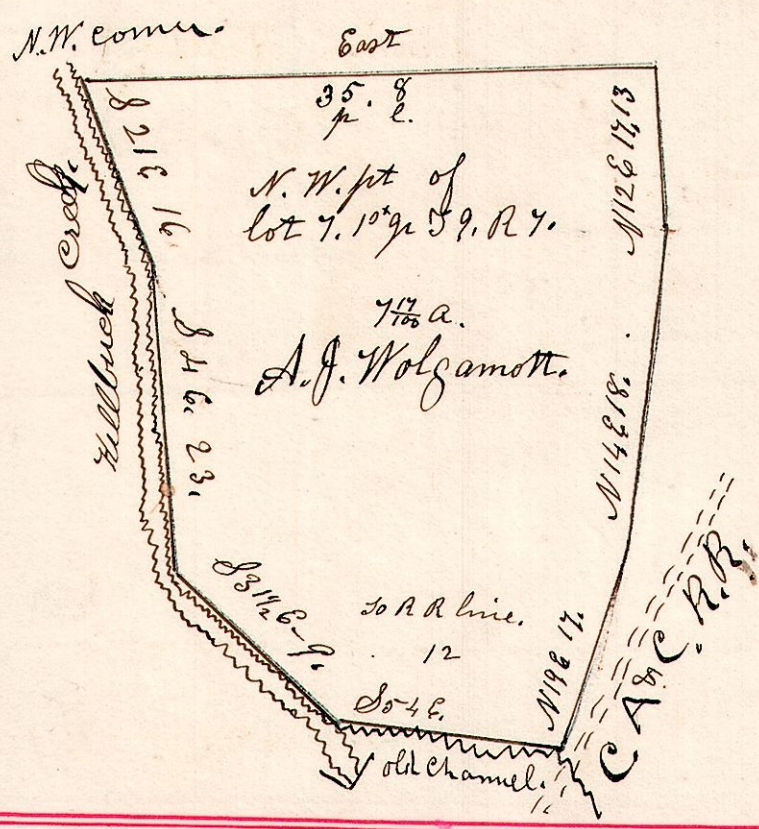


10

7.10.1³⁰/₂

April 13th 1826.

Surveyed lot No. 3rd gr. S 10. R 7. of Military land for Geo Hottes.

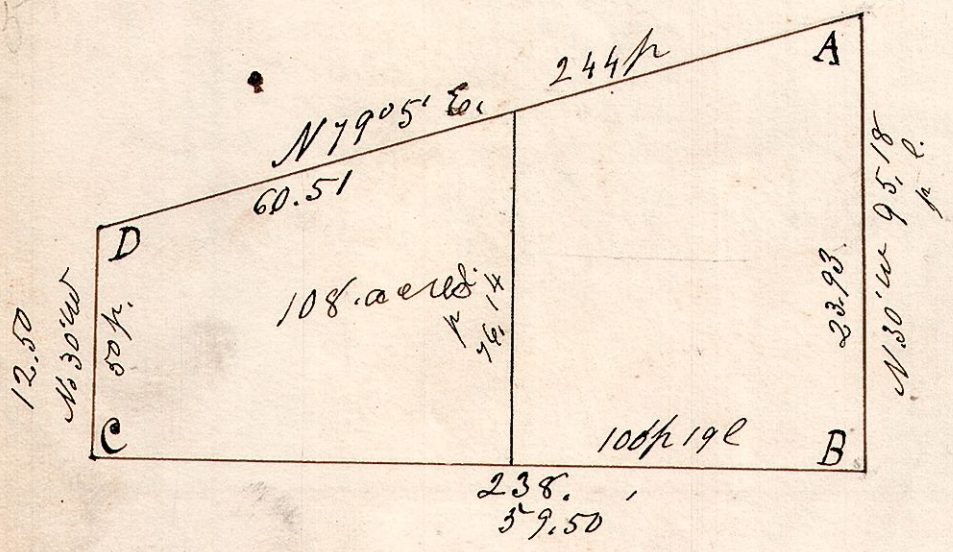


A	Stone Corner		
B	Poplar	18	N 25 E 26
"	R. Oak	14	S 82 E 16
C	Ironwood	8	S 55 E 8
"	Do	7	S 50 W 24
D	W. Oak	30	S 11 W 13
"	Do	28	N 50 E 25

7.9.24³⁰/₂

May 22-1869.

W oak 24 S 60 E 24
Do 20 N 57 W 73

W. Oak 19 N 36 W 23.
Do 18 N 55 E 34.

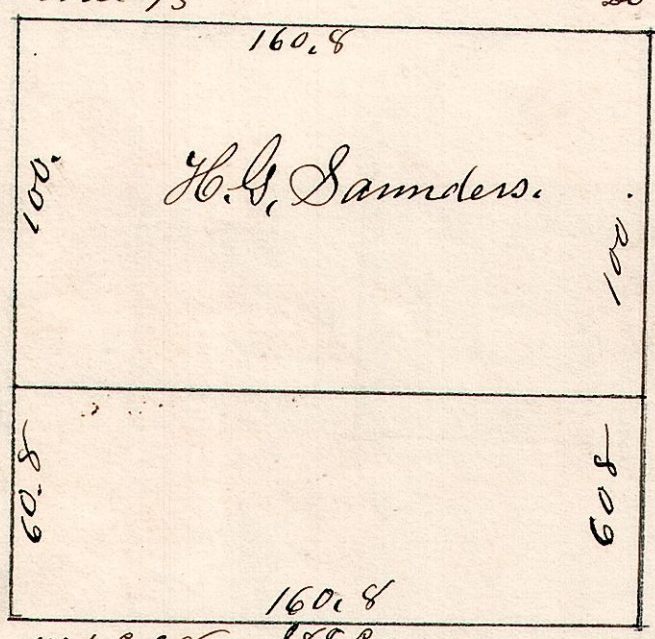

W oak 24 N 24 E 38. 88 E.
Chestnut 25 N 23 1/2 W 66.

Beech 23. N 38 1/2 E 37.
Maple 24. N 33 W 23.