


7. 9. 47. <sup>1st</sup>/<sub>2</sub>

Becketts addition of out lots.  
To Millersburg.

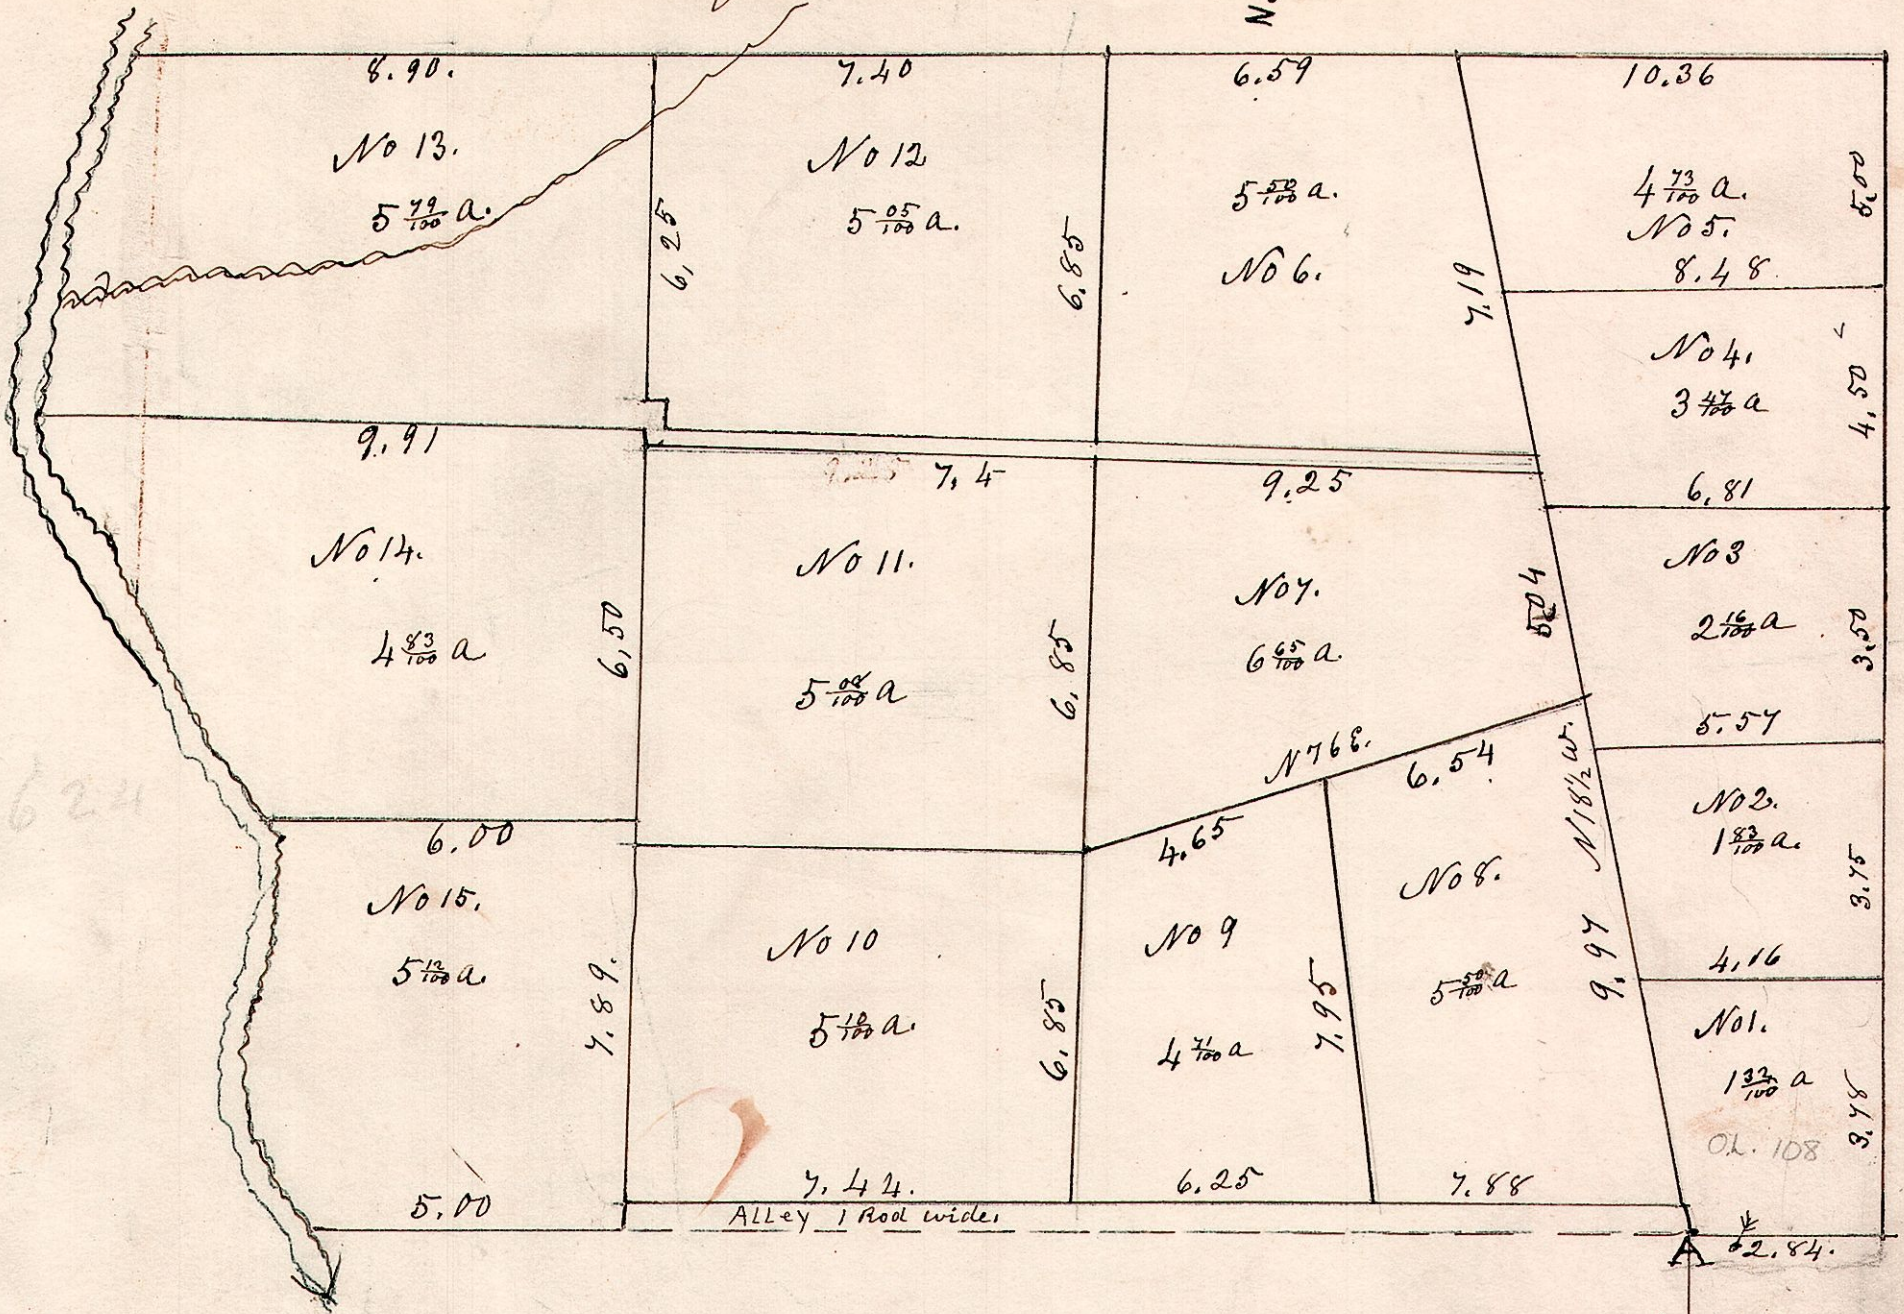


A. Beech 18. 1806 43<sup>l</sup>  
Congress corner

Congress  
line.

7. 9. 46. <sup>1st</sup>/<sub>2</sub>


Lot 46. 1<sup>st</sup> gr 39. R 7.

These lots are sold as sub division of said lot 46.

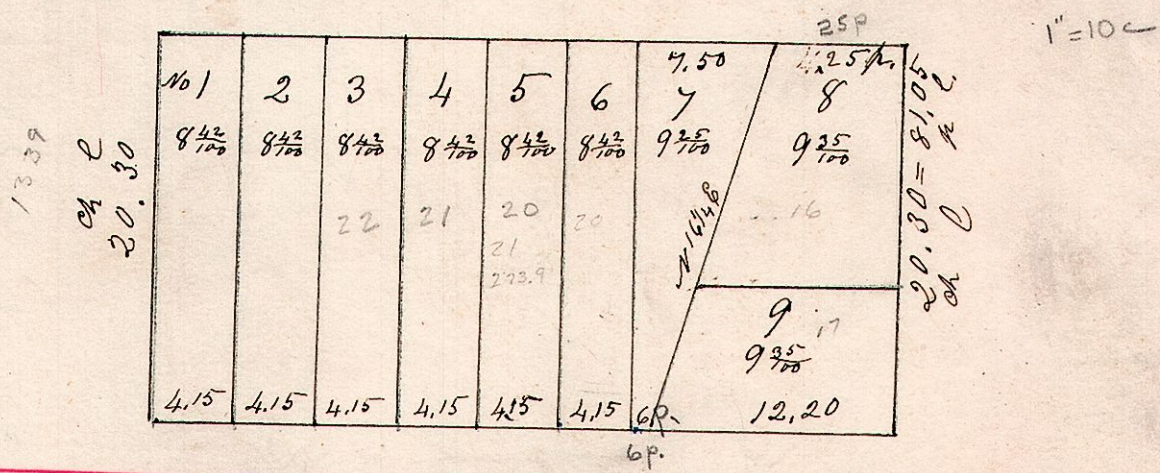

7. 9. 19. <sup>1st</sup>/<sub>2</sub>

July 6<sup>th</sup> 1866. N<sup>o</sup> gr. of Sec 19. 39. R 7.

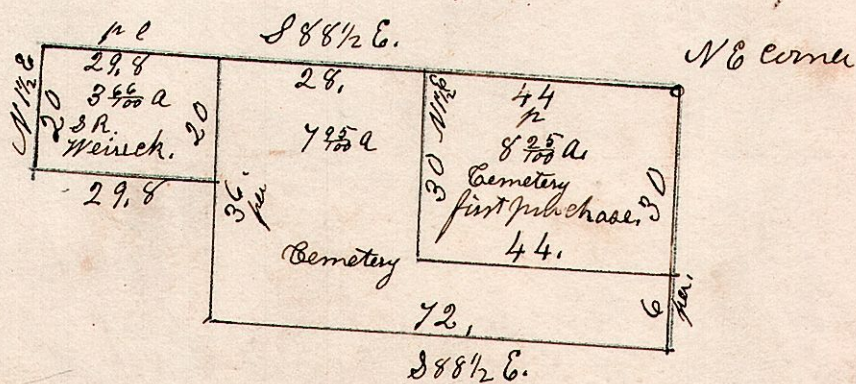

Oak Hills Cemetery grounds, Millersburg Ohio.