



7. 9. 19.

633

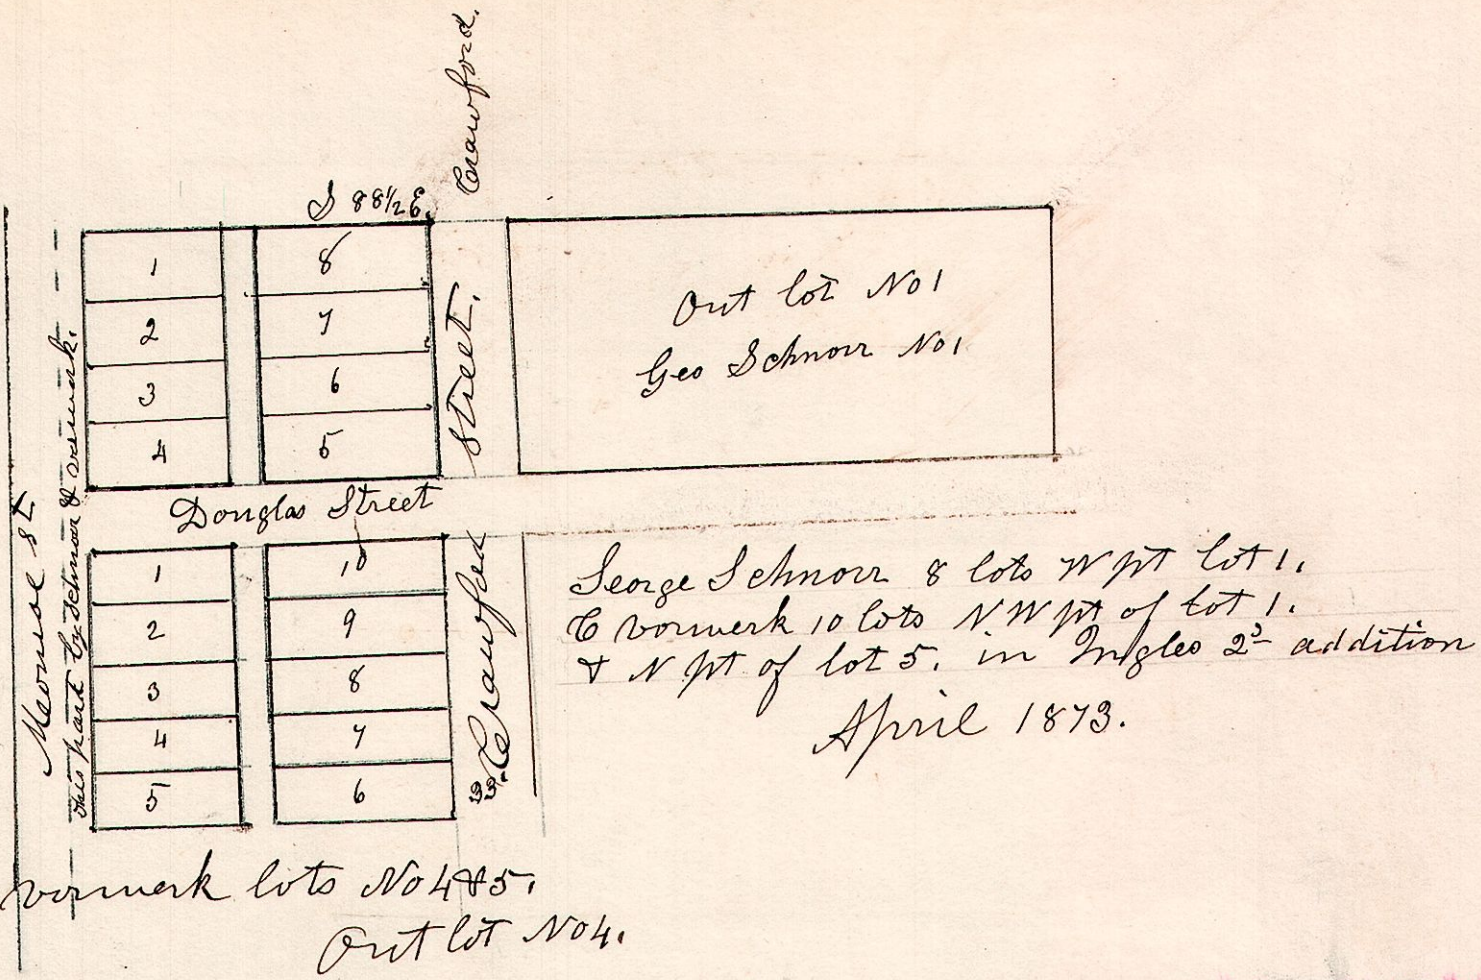

7. 9. 12

634

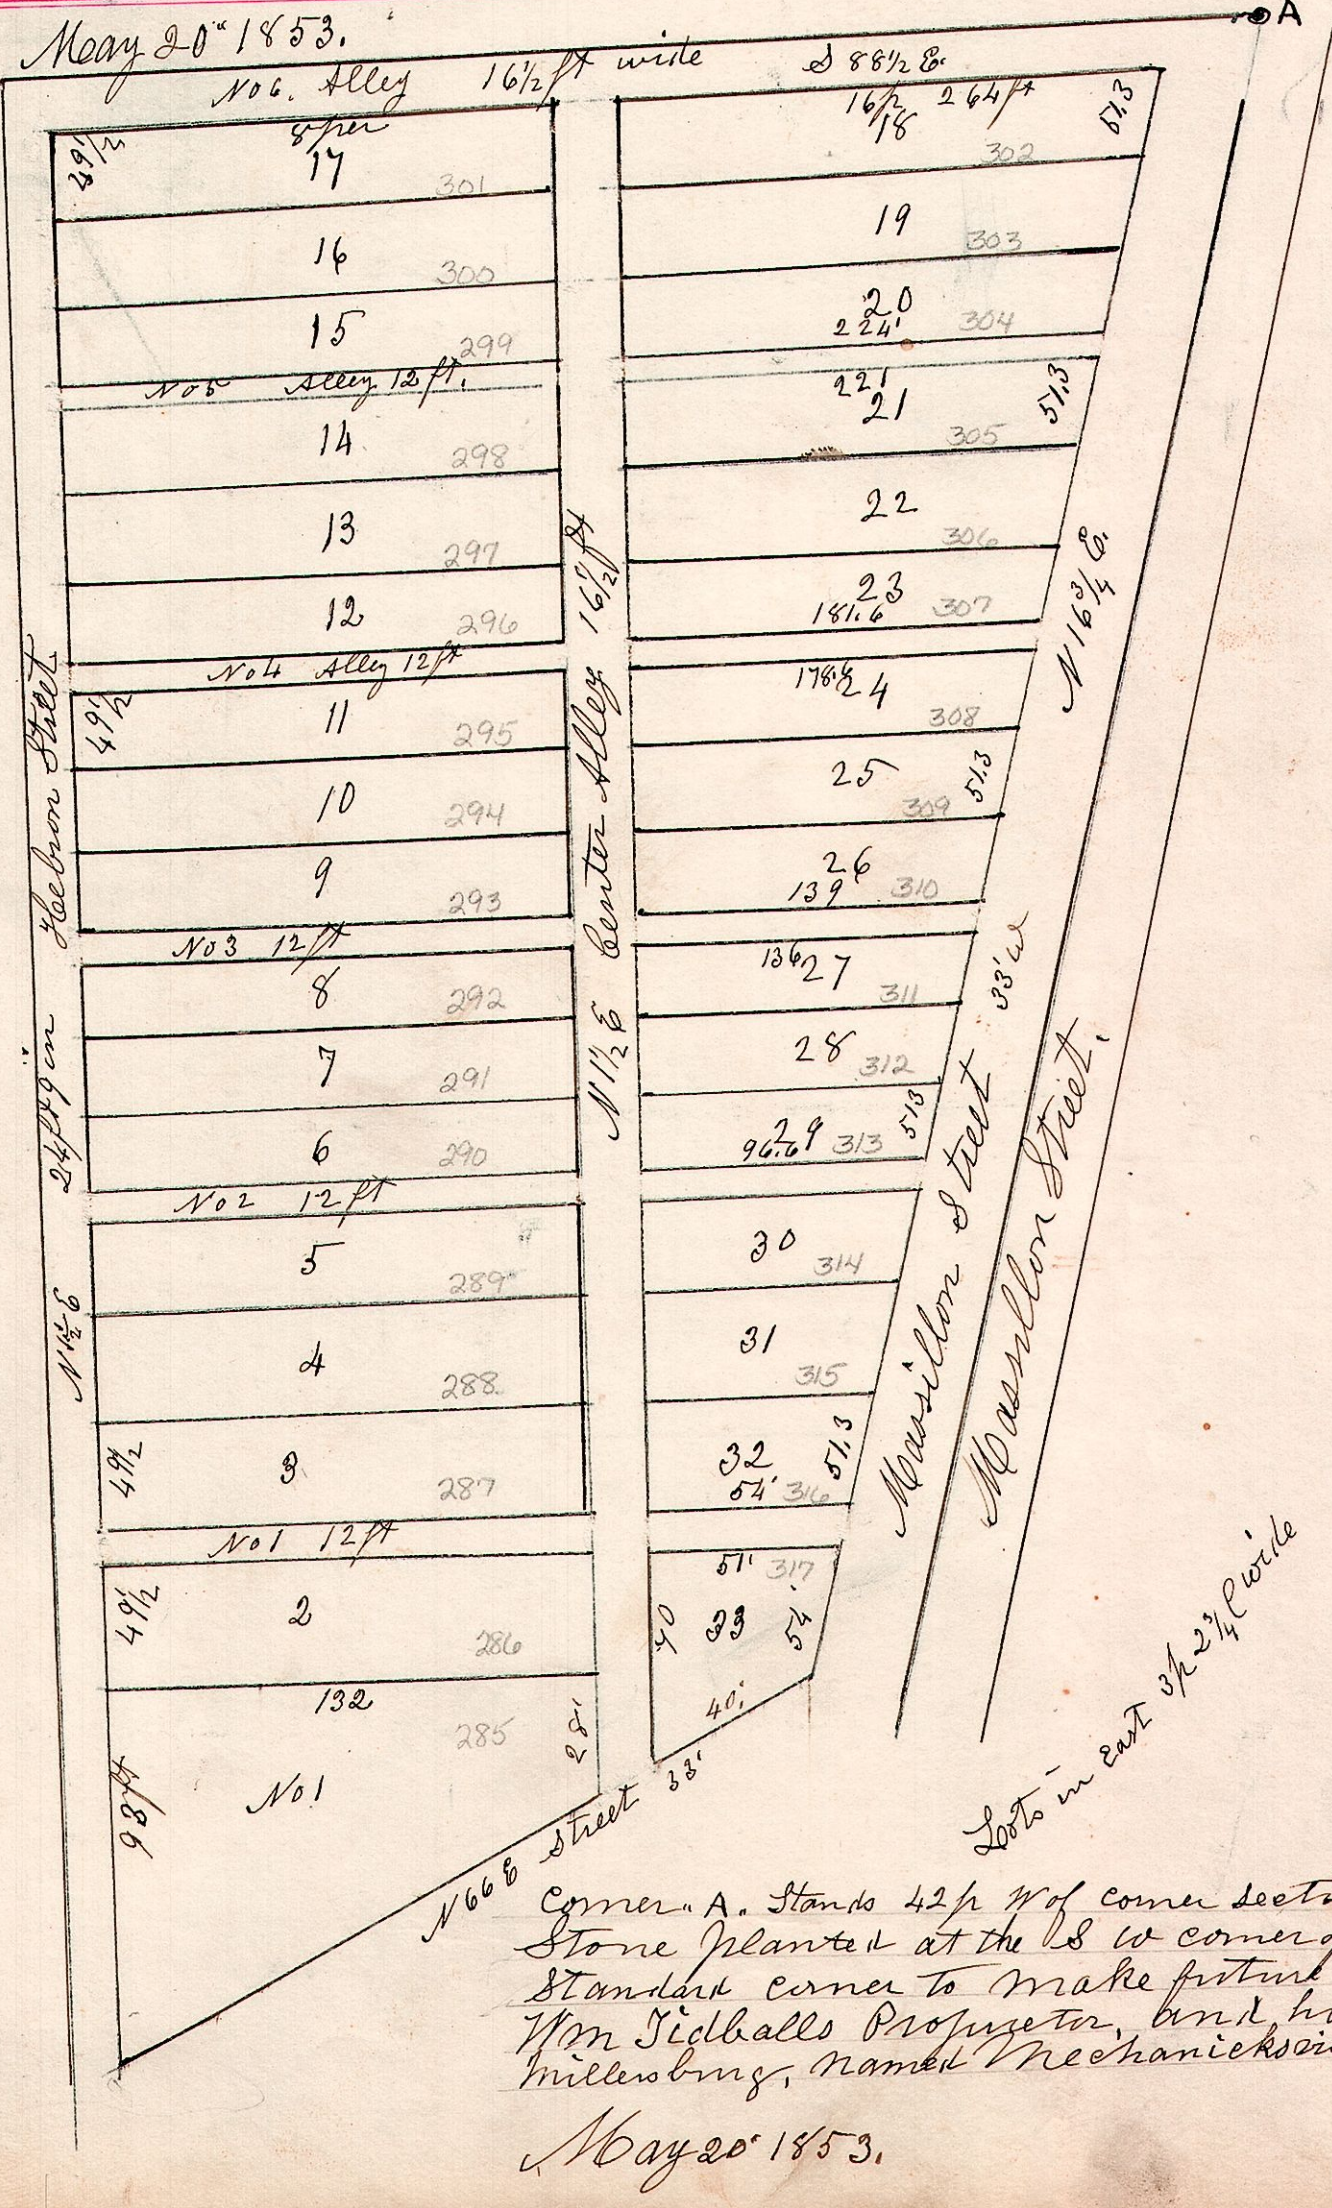

Corner A. Stands 42 ft W of corner section.
 Stone planted at the S.W. corner of lot No 1 for
 standard corner to make future surveys from
 Van Tidballs Proprietor, and his addition to
 Millersburg, named Mechanicsville.

May 20 1853.