6. 9. 11 4/4

March 30th 1871.

W pt Lot No 11. in 4th qr Township. 39. R 6.
Peter Wise Survey.

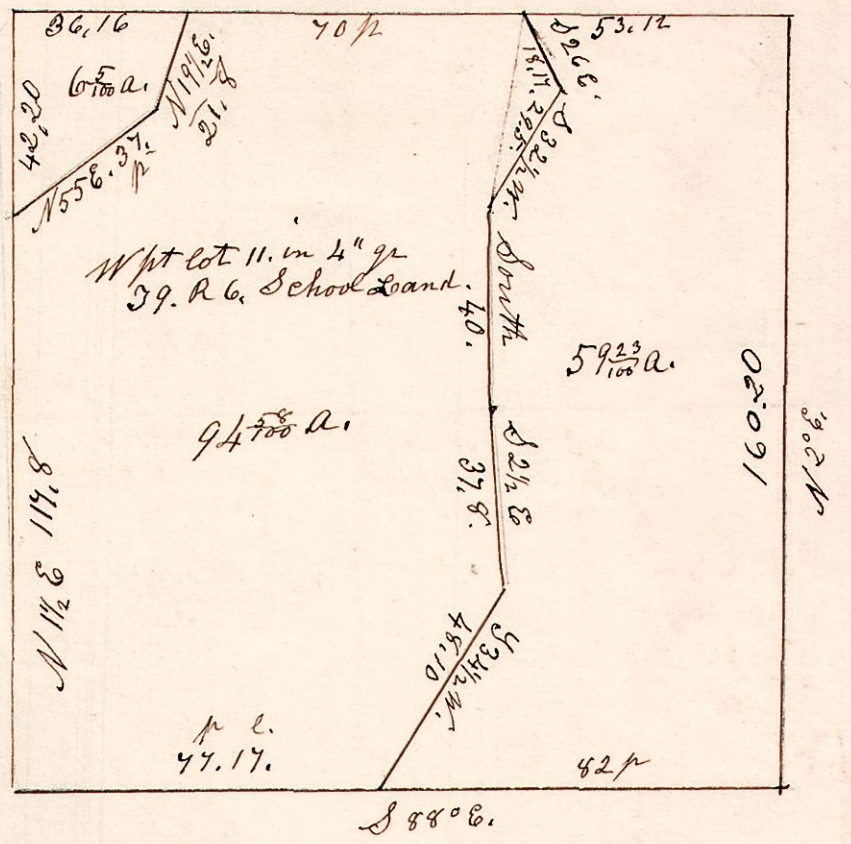

Peter Wise
March 30th 1871.

6. 8. 23. 3/4 qr.

May 13th 1873.

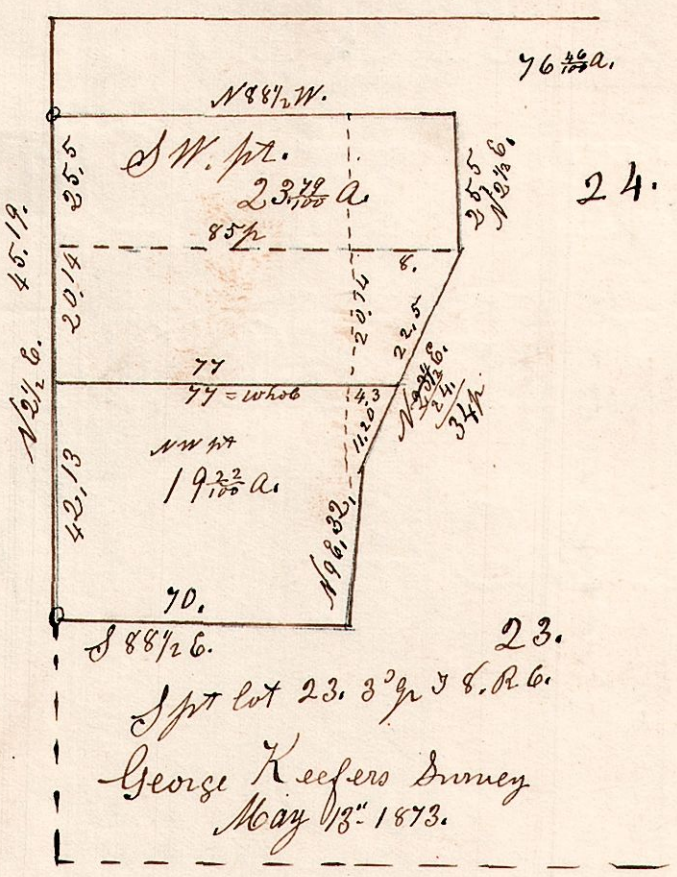

24.

23.

S pt lot 23. 3rd qr T 8. R 6.

George Keefers Survey
May 13th 1873.

6. 8. 29 2/4 qr.

December 6th 1858.

Lot 29. in Tp 8. of R 6. 2d qr.

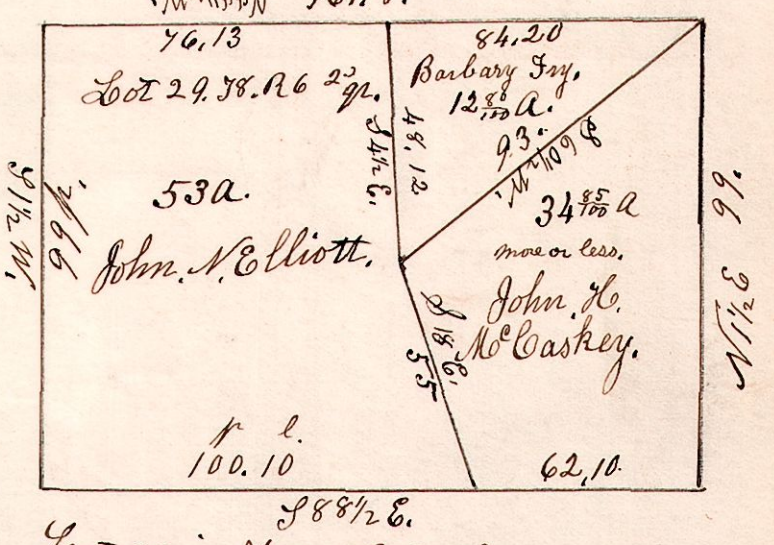

Lot 29. in Tp 8 of R 6. 2d qr.
December 6th 1858.

6. 8. 13.

March 13th 1851.
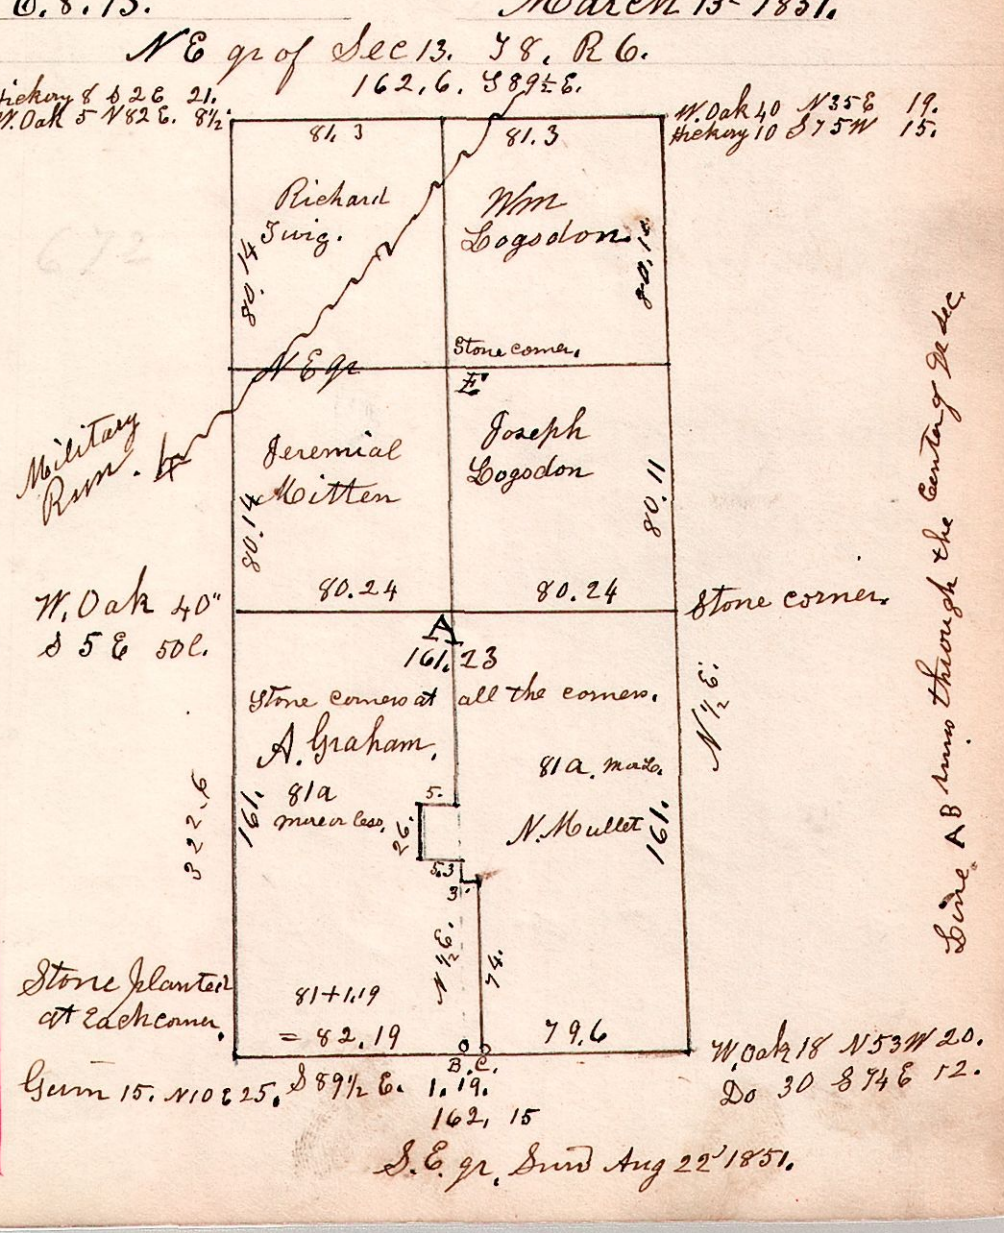
NE qr of Sec 13. T 8. R 6.
162.6. S 89 E.