6.9.9. 1/4 November 14th 1849. Surveyed Lot 9. 1st qr Tp 9. R 6.
Ct W.R. School Land.

W Oak 10 S 50 W 20.
Do 9 S 11 E 19.

W. Oak & S 54 E 12.
Dogwood 9 S 50½ W 29.

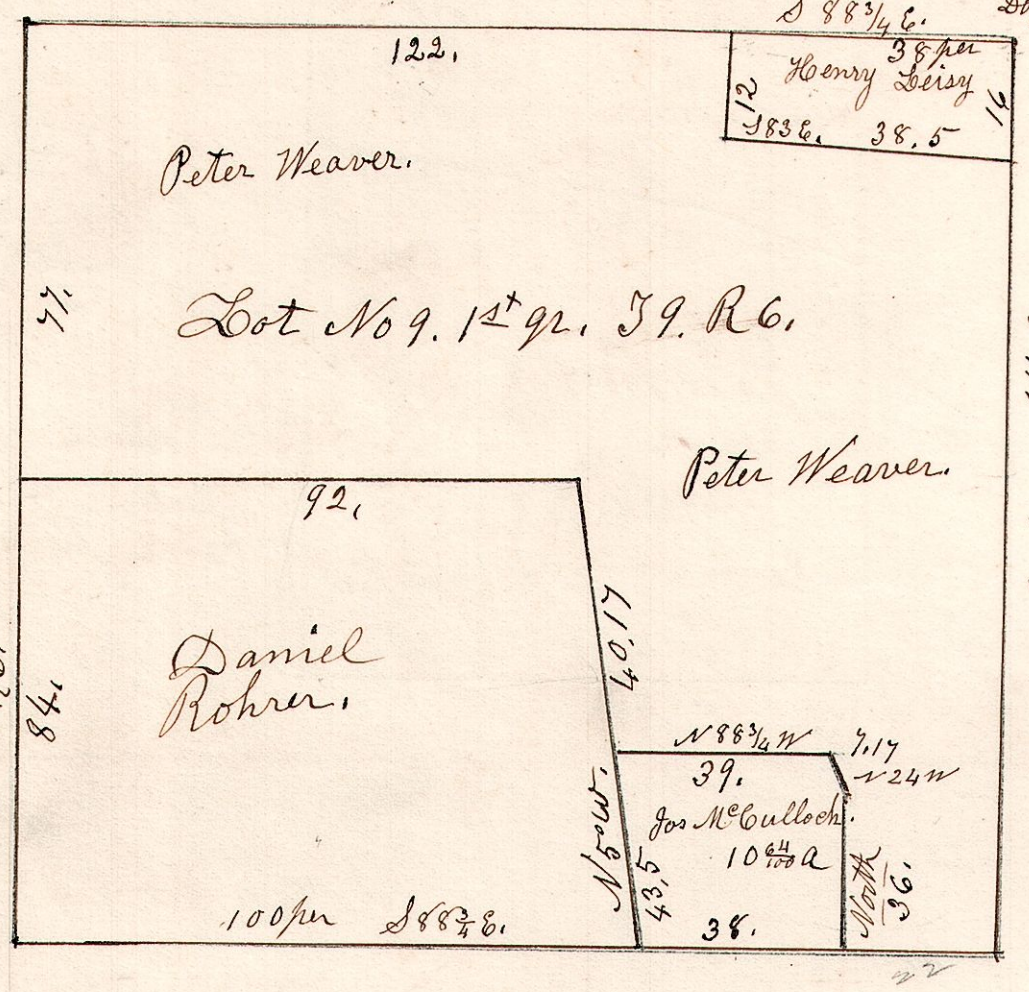

W Oak 14 S 43 E 36.
Maple 9 N 39 E 34.

W Oak 9 N 12 W 20.
Do 13 S 36 E 36.

6.9.4 SE qr 1. February 7th 1854. SE qr Sec 4. T 9. R 6.

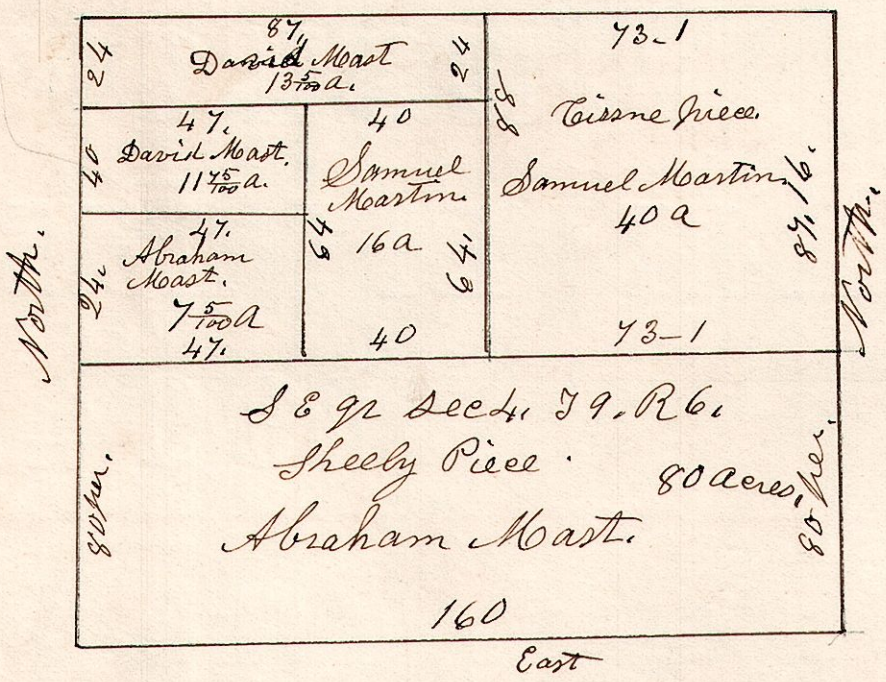

Feb 7th 1854.

Deed from A Mast & Elisabeth his Wife to Samuel Martin for 16 acre piece, consideration money 25 dollars per acre. Deed from Same to David Mast for 11 75/100 acre piece. Cons money 25 dolls per acre.