


6.9.4. N.E. qr of Sec 4, T9. R6. Feb 6<sup>th</sup> 1860.

N.W. qr of Sec 4, T9. R6.

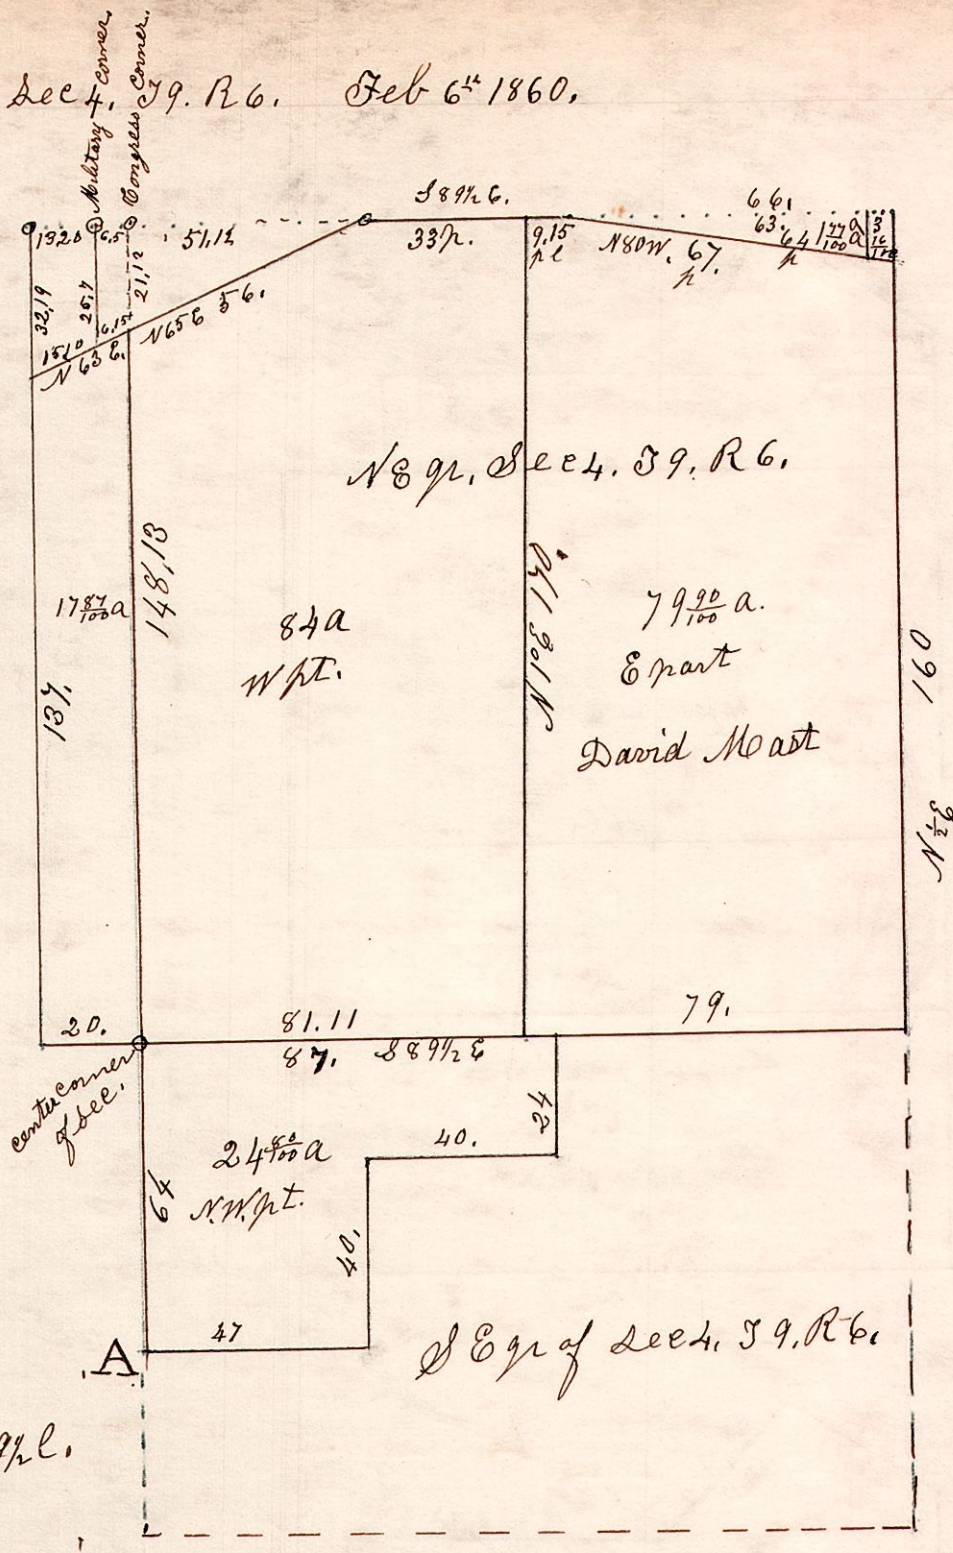


Feb 6<sup>th</sup> 1860.  
Surveyed for A Moast &  
D. Moast.

A. Beech 16 W 9 1/2 E.

6.8.1. December 3<sup>rd</sup> 1829. Surveyed the S.W. qr of Sec 1, in T8 of R6. in the following manner for Peter Mishler.

Hickory 12 N 80 E 16.  
Ash 5 N 80 W 11.

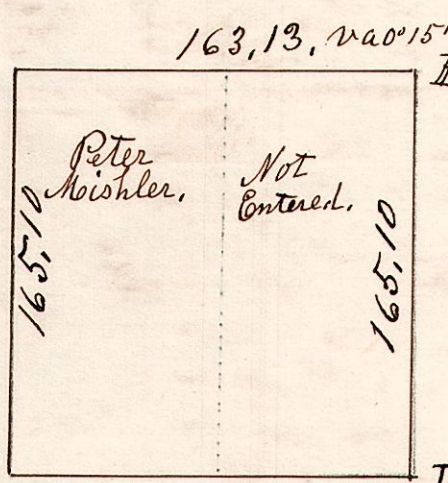


Maple 18 the corner.

S.W. qr of Sec 1, T8, R6.

Hickory 13 S 37 W 3.  
W. Oak 30 N 54 E 10.

6.9.23. 1/2 W.

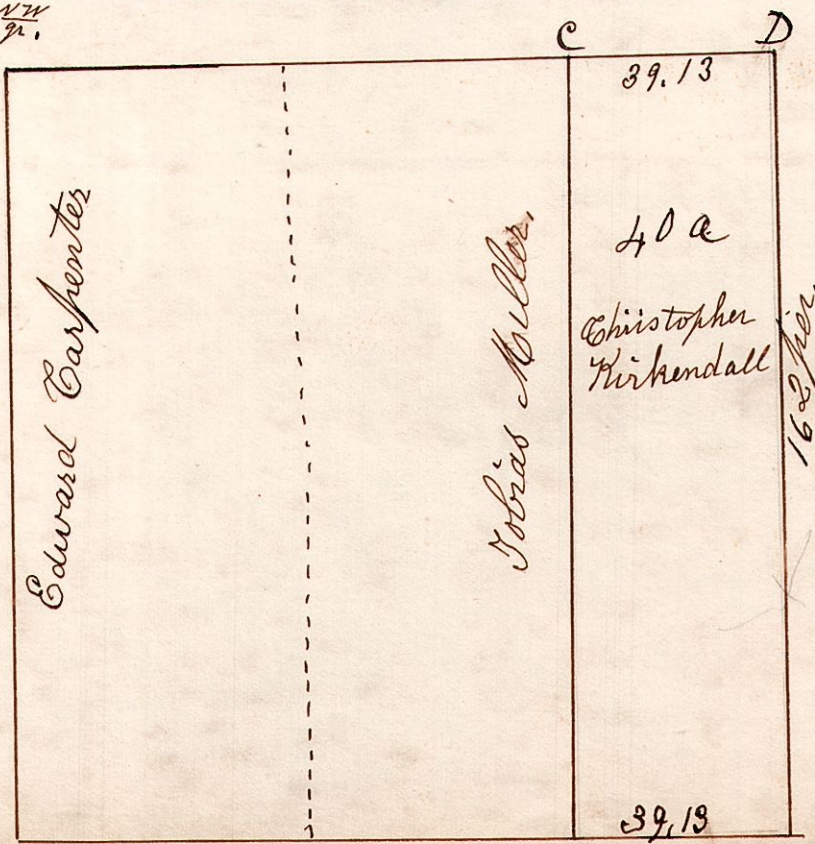

Sept 18<sup>th</sup> 1854.  
North west quarter of S 23, in  
Township 9, of Range 6.

40 a  
Christopher  
Kirkendall