


6.9. 3. ¹⁰⁺/₄.

Lot No. 3. in the 12th gr. in Twp 9. of Range 6. School

160-15.


September 2nd 1837.

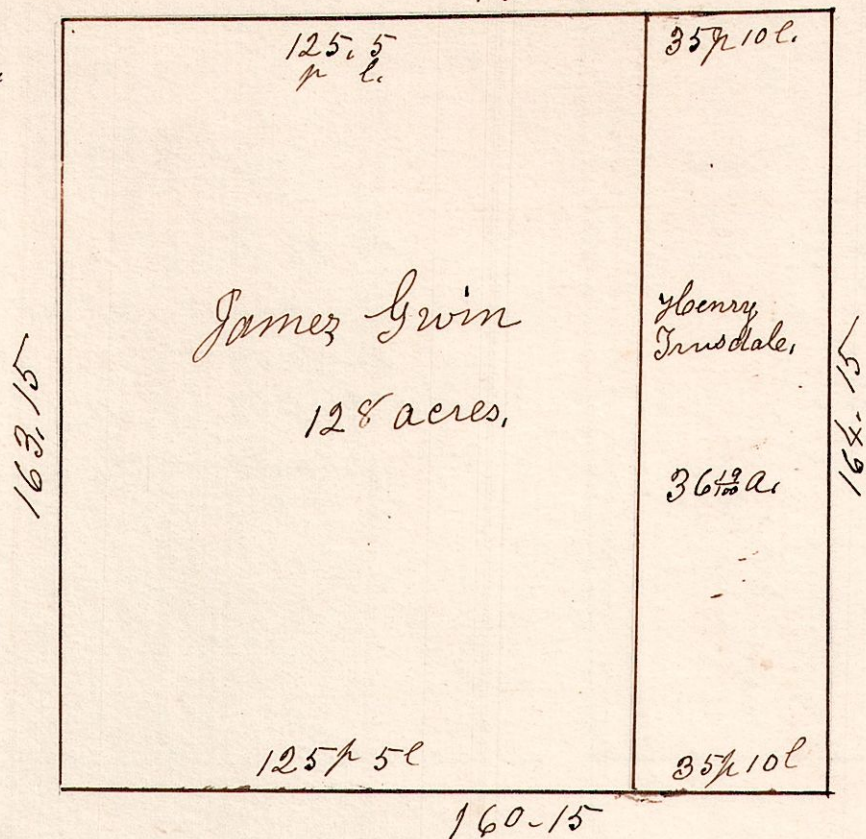

6.9. 17. NW.

N.W. gr. Sec 17. in Twp 9. of R 6.

May 26th 1855.

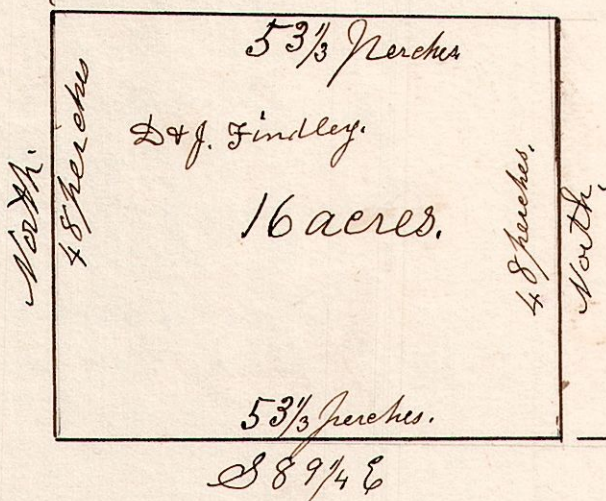

I do hereby certify that the above is a correct plat of the South west part, of the north west quarter of Section 17. in Township 9. of Range 6.; containing 16 acres, Holmes County Ohio.

Samuel Robinson
Surveyor.