


5. 10. 3 + 4. <sup>30</sup>/<sub>4</sub>

April 1<sup>st</sup> 1859.


Vileott Survey on west part of lot 4. above to be platted out 1 acre more.

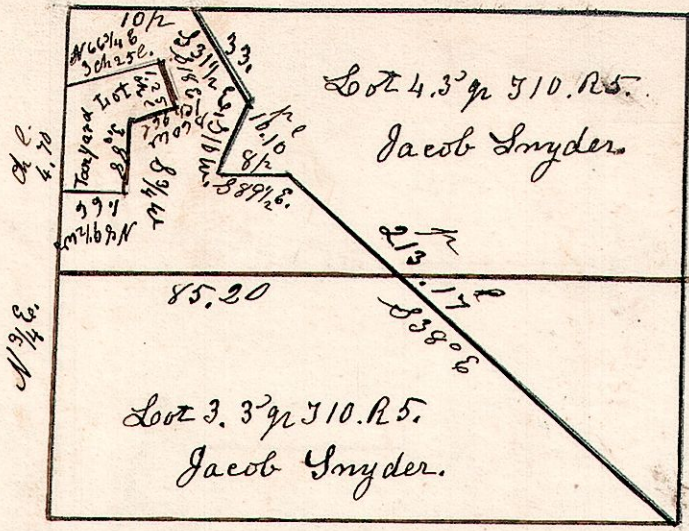

Jacob Snyder  
April 21<sup>st</sup> 1859


5. 9. 15.

January 1<sup>st</sup> 1829.

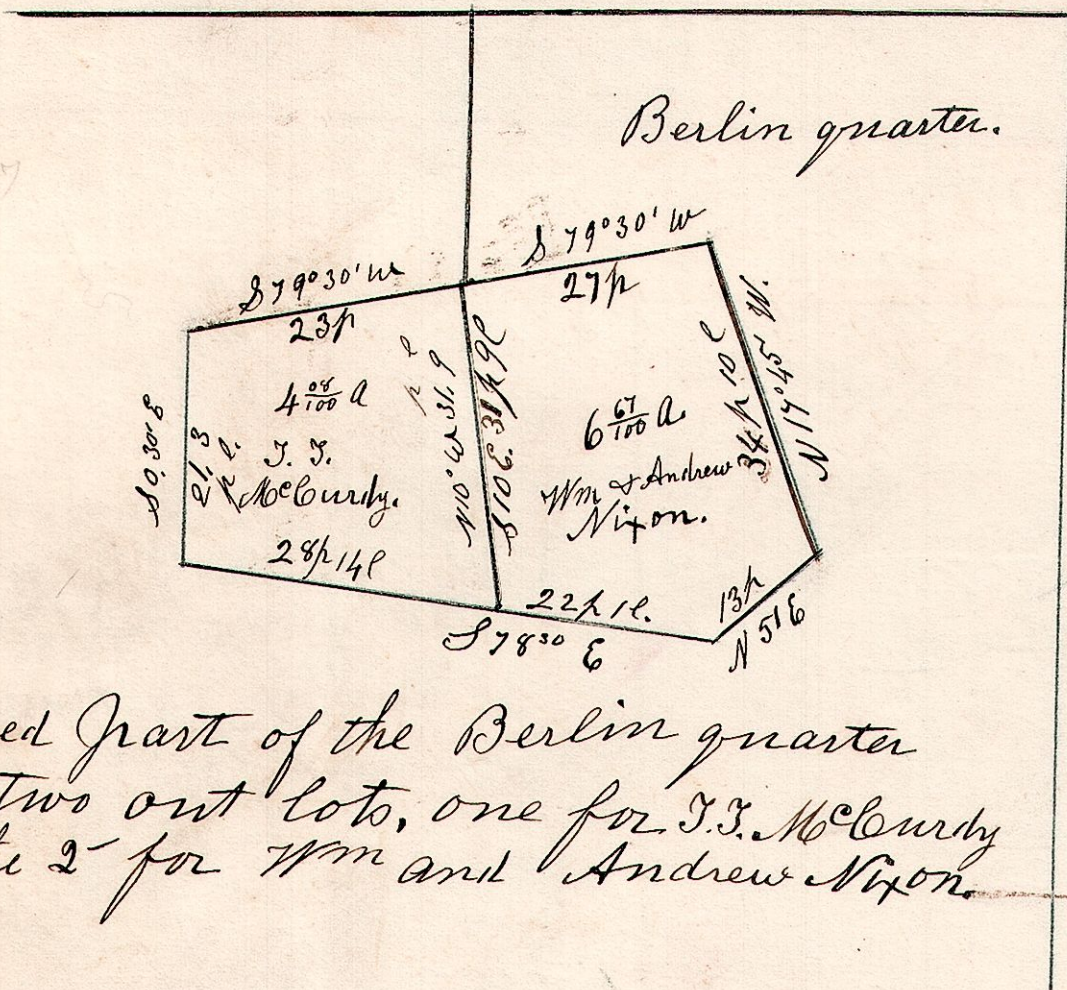

Surveyed part of the Berlin quarter being two out lots, one for J. S. McCurdy and the 2 for Wm and Andrew Nixon.

5. 8. 12. <sup>11.8</sup>/<sub>pr</sub>

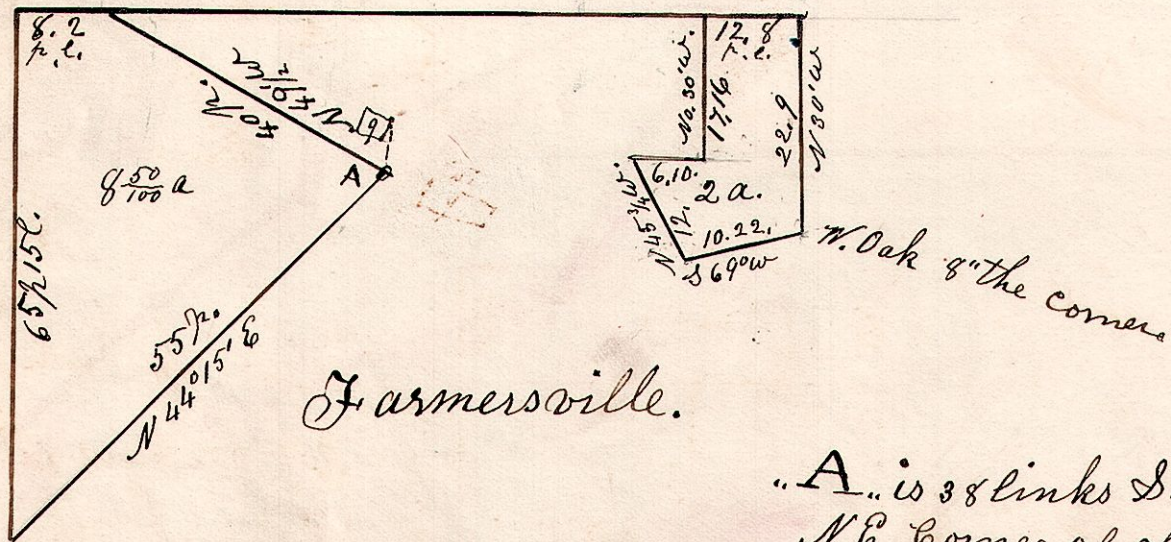

"A" is 38 links South of the N.E. corner of lot 9.