



5. 8. 15.

August 16<sup>th</sup> 1841.  
 Surveyed the north west quarter of  
 Section 15. in Township 8. of Range 55.

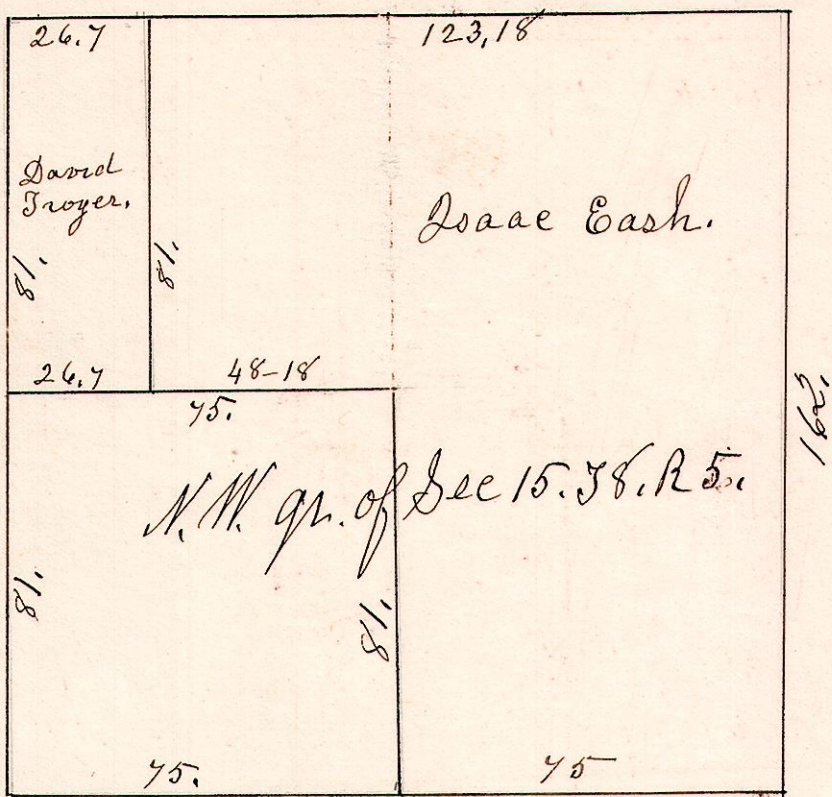

6. 8. 10. April 19<sup>th</sup> 1851.

From c to D, 4 p 10 c mark on rock  
 for a standard mark corner to  
 govern the height of the water  
 between the 2 water privileges

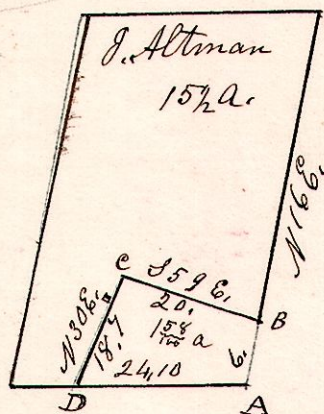

Surveyed in 1833.

Surveyed April 19<sup>th</sup> 1851.

