


6.10.21.  $\frac{4}{2}$

June 1<sup>st</sup> 1866.

Surveyed for Isaac  
Piper guardian.

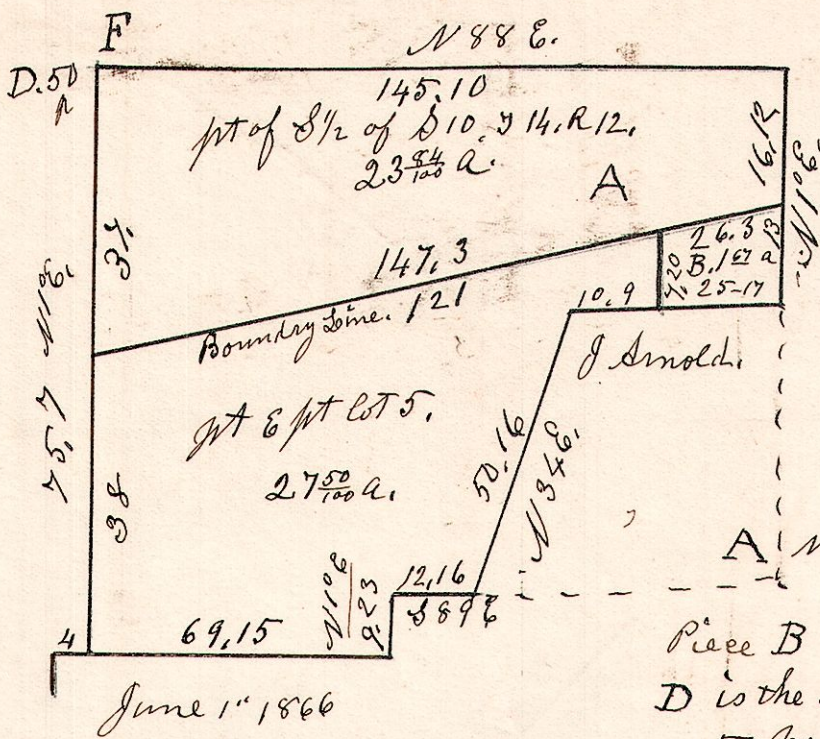


June 1<sup>st</sup> 1866

piece B, NW pt  
of lot 21, 1/4 Sec 10 R 12  
1 67/100 a  
C

A NE cor of lot 5.  
Piece B is NW corner of lot 21  
D is the NW corner of 8 1/2 of sec 10, T 14, R 12  
50 perches to F

15.20.34.

November 10<sup>th</sup> 1825.

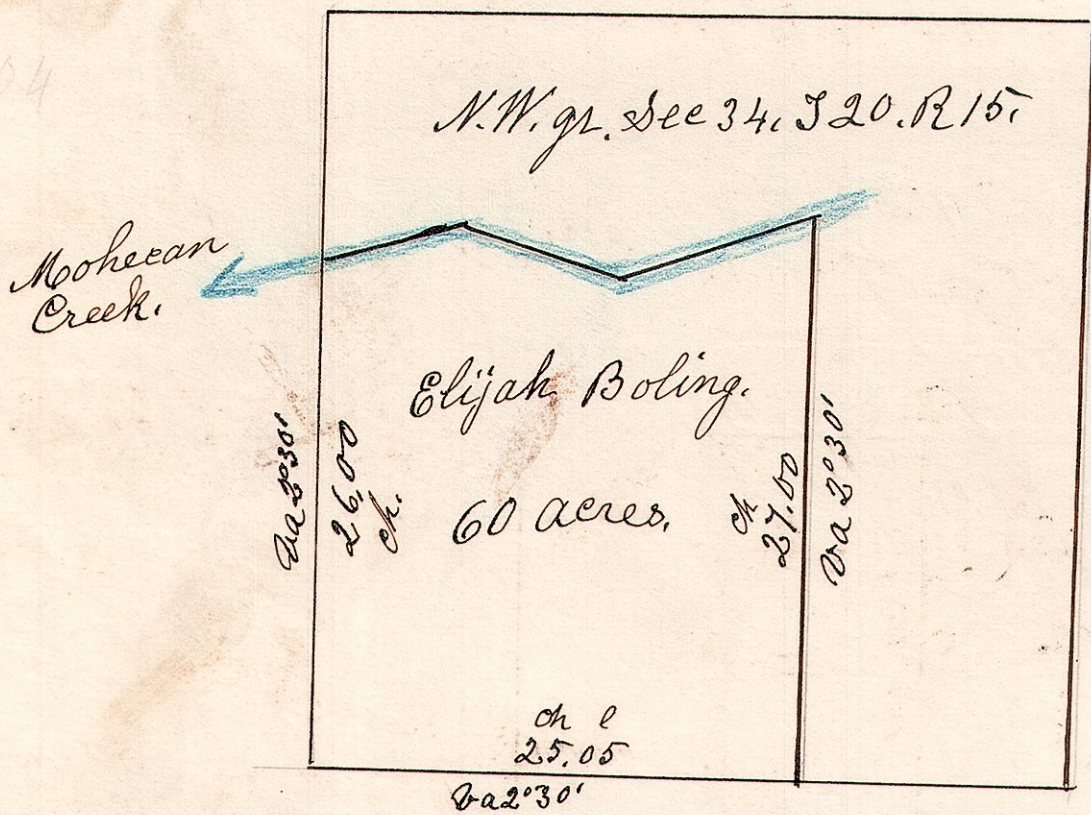

Surveyed the above November 10<sup>th</sup> 1825, being the South west part of the north west quarter of section 34 in Township 20. of Range 15. Beginning on the west line of said quarter section in the center of Moheean Creek; Thence south 2°30' East 26 chains to the south west corner of said quarter section; Thence north 87°30' East 25.05 chains and 5 Links to a post; Thence north 2°30' west 27.00 chains to the center of Moheean Creek; Thence along the center of said Moheean Creek, the meanderings of said creek to the place of beginning of which the above is a correct plat of the same.

Samuel Robinson  
Co. Surveyor.