6. 10. 16. 4th qr.

June 11th 1835.

Surveyed lot 16. in 4th qr. in T. 10 of R 6
for David Snyder.

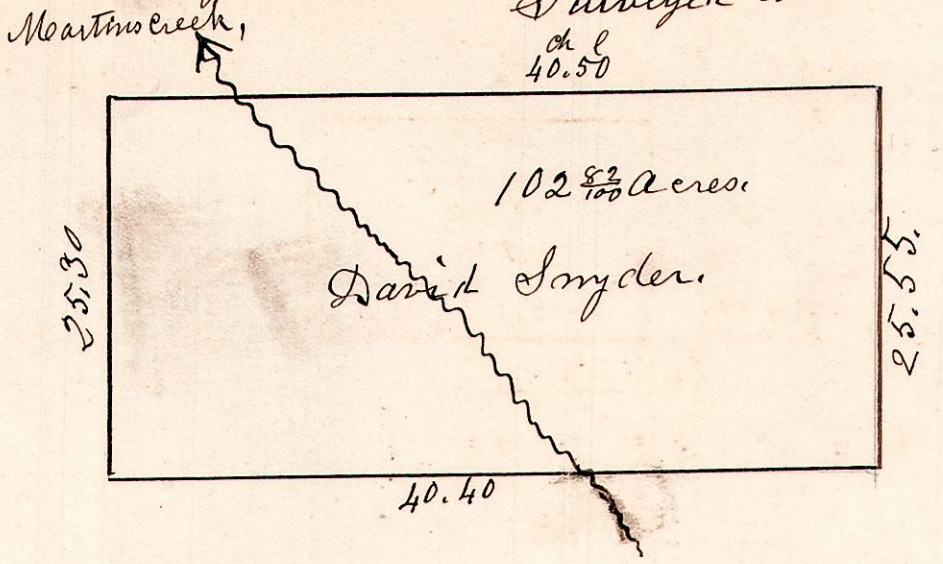

821

---

6. 10. 1-2-17-18 3d qr

822

October 9th 1856.

3 qr. T 10. R 6.

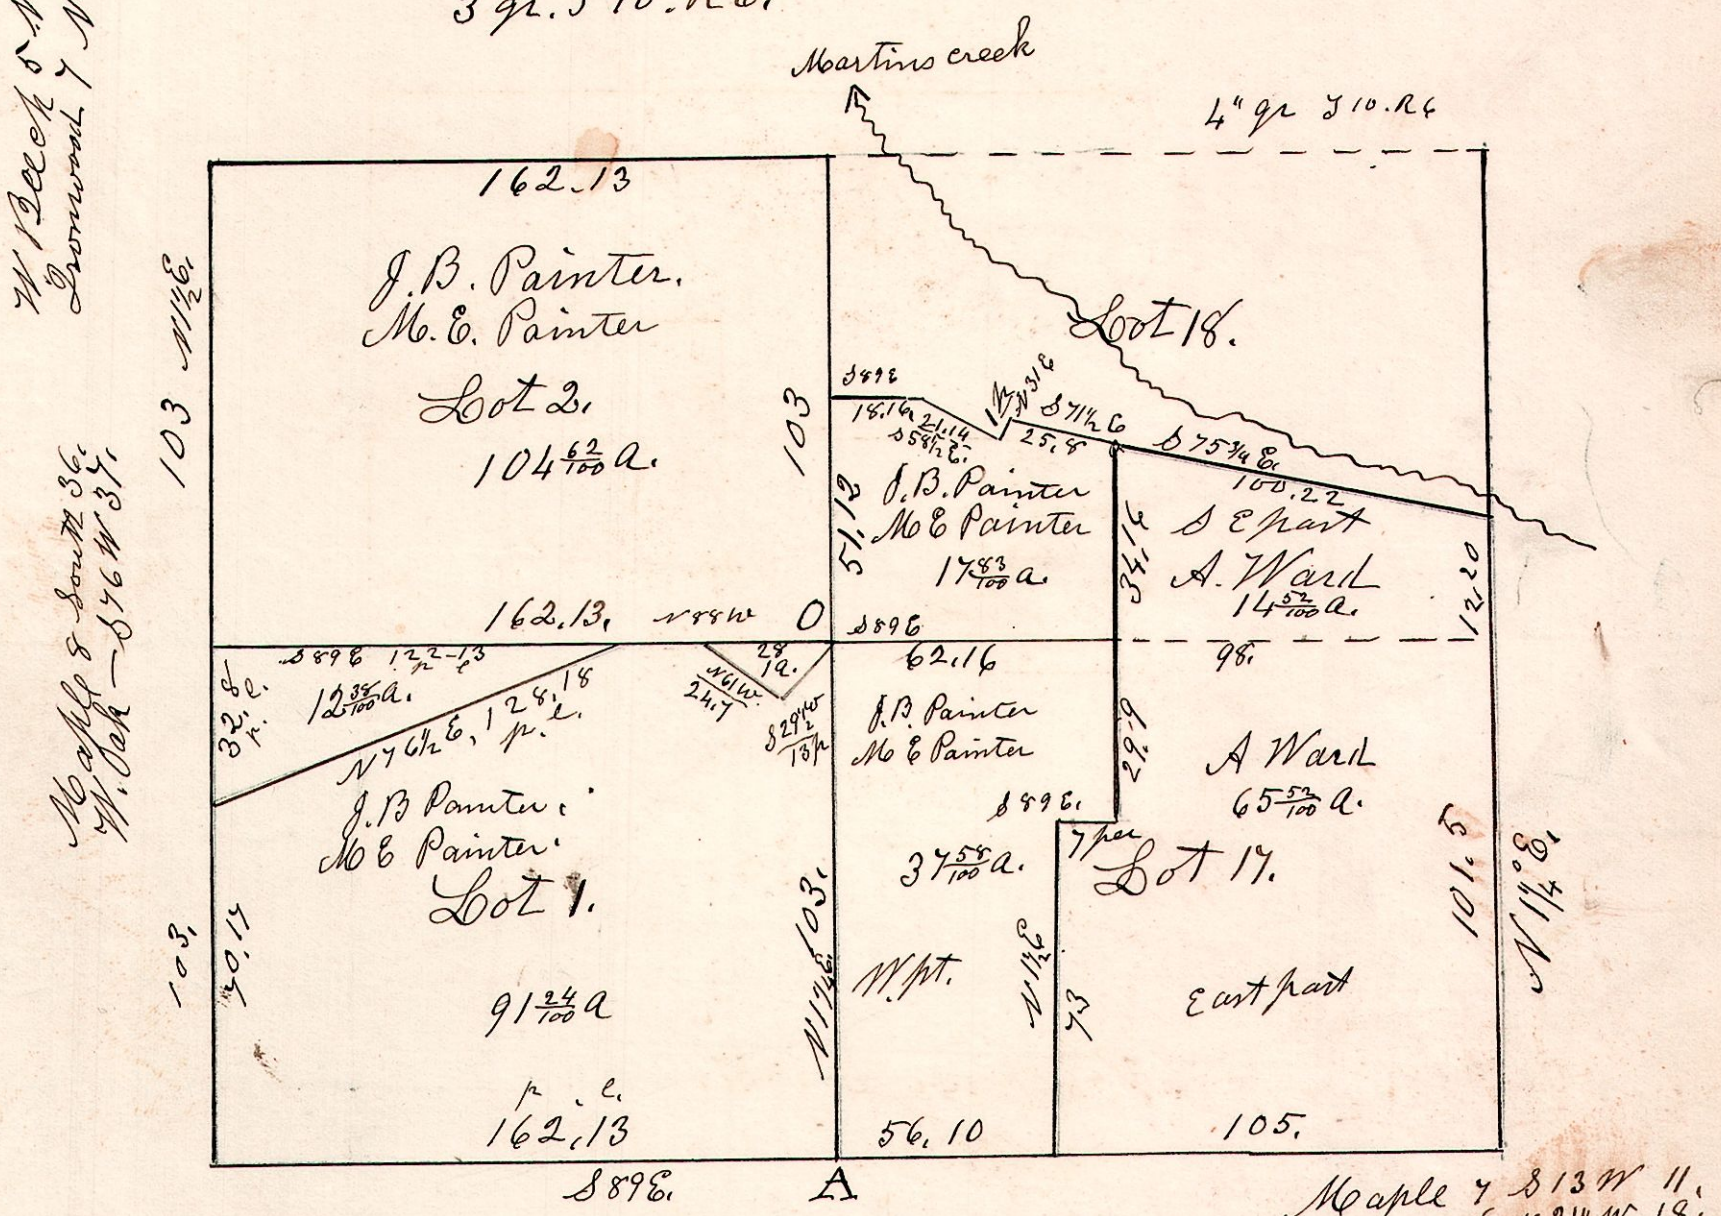

O. Sugar 11 S 18 W 20.
" Hickory 12 N 71 W 10.

School Land corner. Hickory 5. S 38 E. 38.