


6.10.9³/₄

August 24th 1865

836

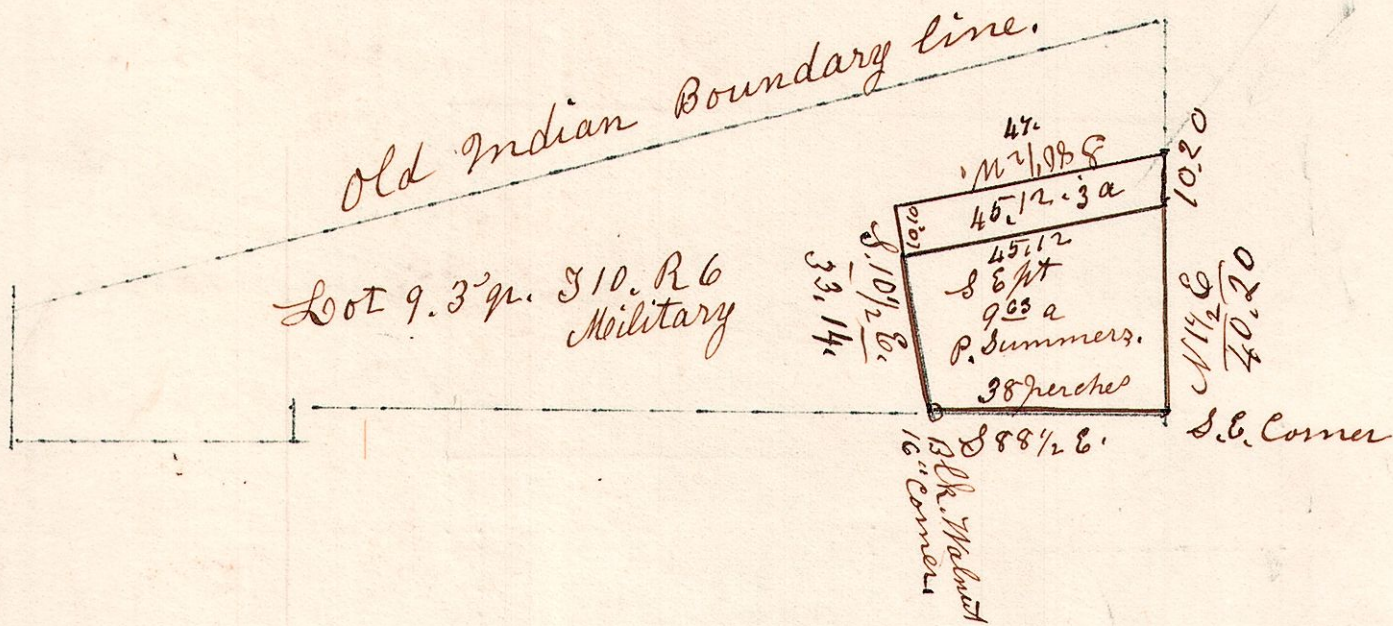


3

6.9.11.1st q₂

June 3rd 1835.

Lot 11th 1st q₂ T9, R 6.


June 3rd 1835 Surveyed
 50 acres being the north
 part of lot 11 in the 1st q₂
 of Township 9 of Range 6.
 School land, Berlin
 Township.

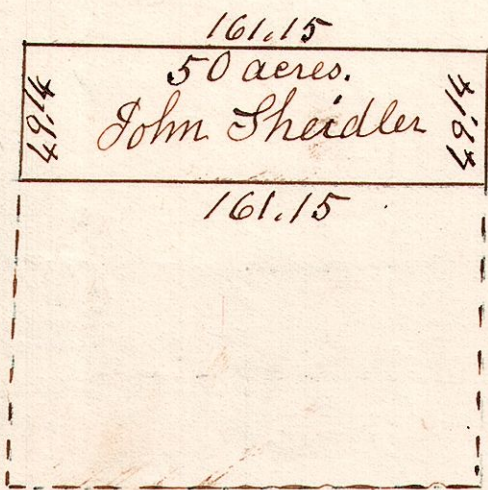

4

6.9.23. 4th/₄ School land

Surveyed NW 1/4
 August 21st 1863. Friday.

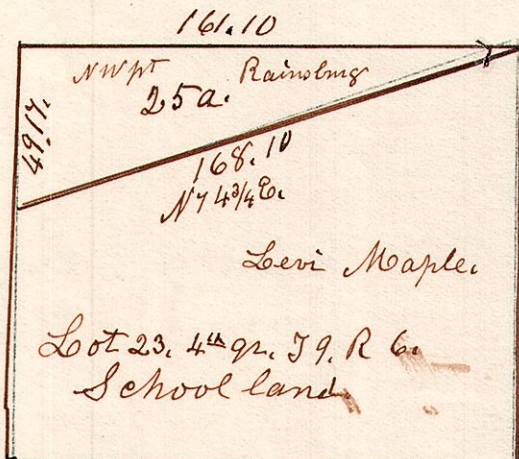

5