



6.9.20 ^{1/2} May 31st 1841.

1841.

Surveyed lot 20 in 1st qr 7th.
T 9. R 6. School Land.
(Post at each corner)

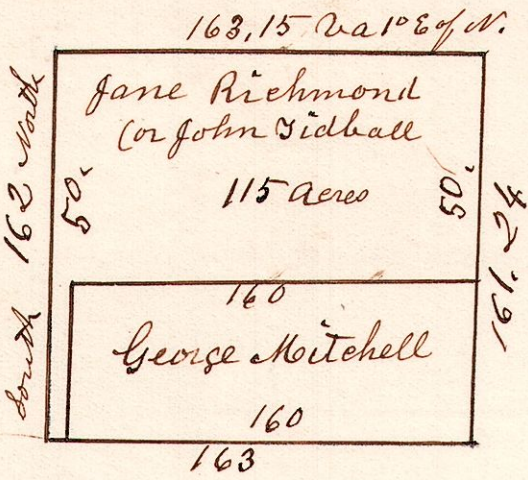

6.8.2.2^{3/4} February 10th 1836.

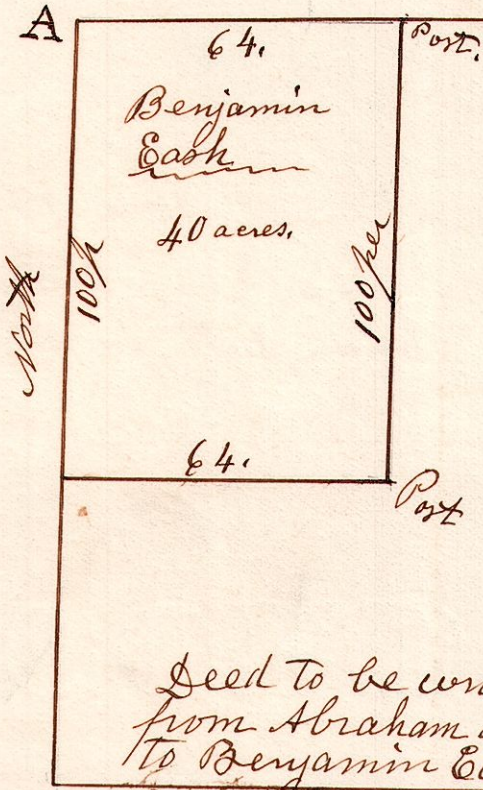

February 10th 1836.
Surveyed the above 40 acres,
Being the NW part of of the
S.E. quarter of Sec 2 in T 9. R 6.

A. Beech 16 S 52 E 5.
" Maple 12 N 81 W 17.

Deed to be written for the above 40 acres
from Abraham Nyoder & Susanna his wife
to Benjamin Cash } consideration \$110.

6.9.16.1st School Land

June 3rd 1835.
Surveyed 50 acres.
Being the South part
of lot 16, in the 1st qr
T 9. R 6. School Land.
in Berlin Township
Sold by Wm Lewis
to Adam Edelman.

