


Jacob Nyoder land.

6.9.6
6-9-5

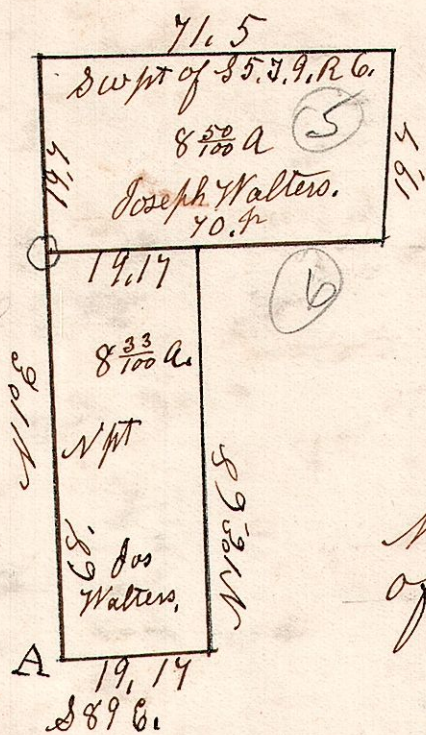

South west part of Sec 5.
in Township 9. of Range 6.


1870.

North part of North west quarter
of Sec 6. in T. 9 of Range 6.

6-9-25.

July 18th 1872.

D. Baughman.

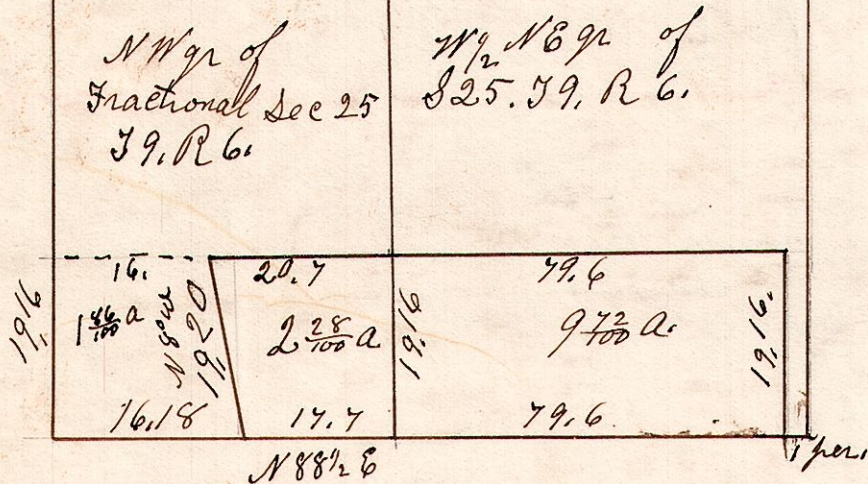

Surveyed 12 acre piece for
D. Baughman July 18th 1872.