


6.8-2.


October 27th 1870.

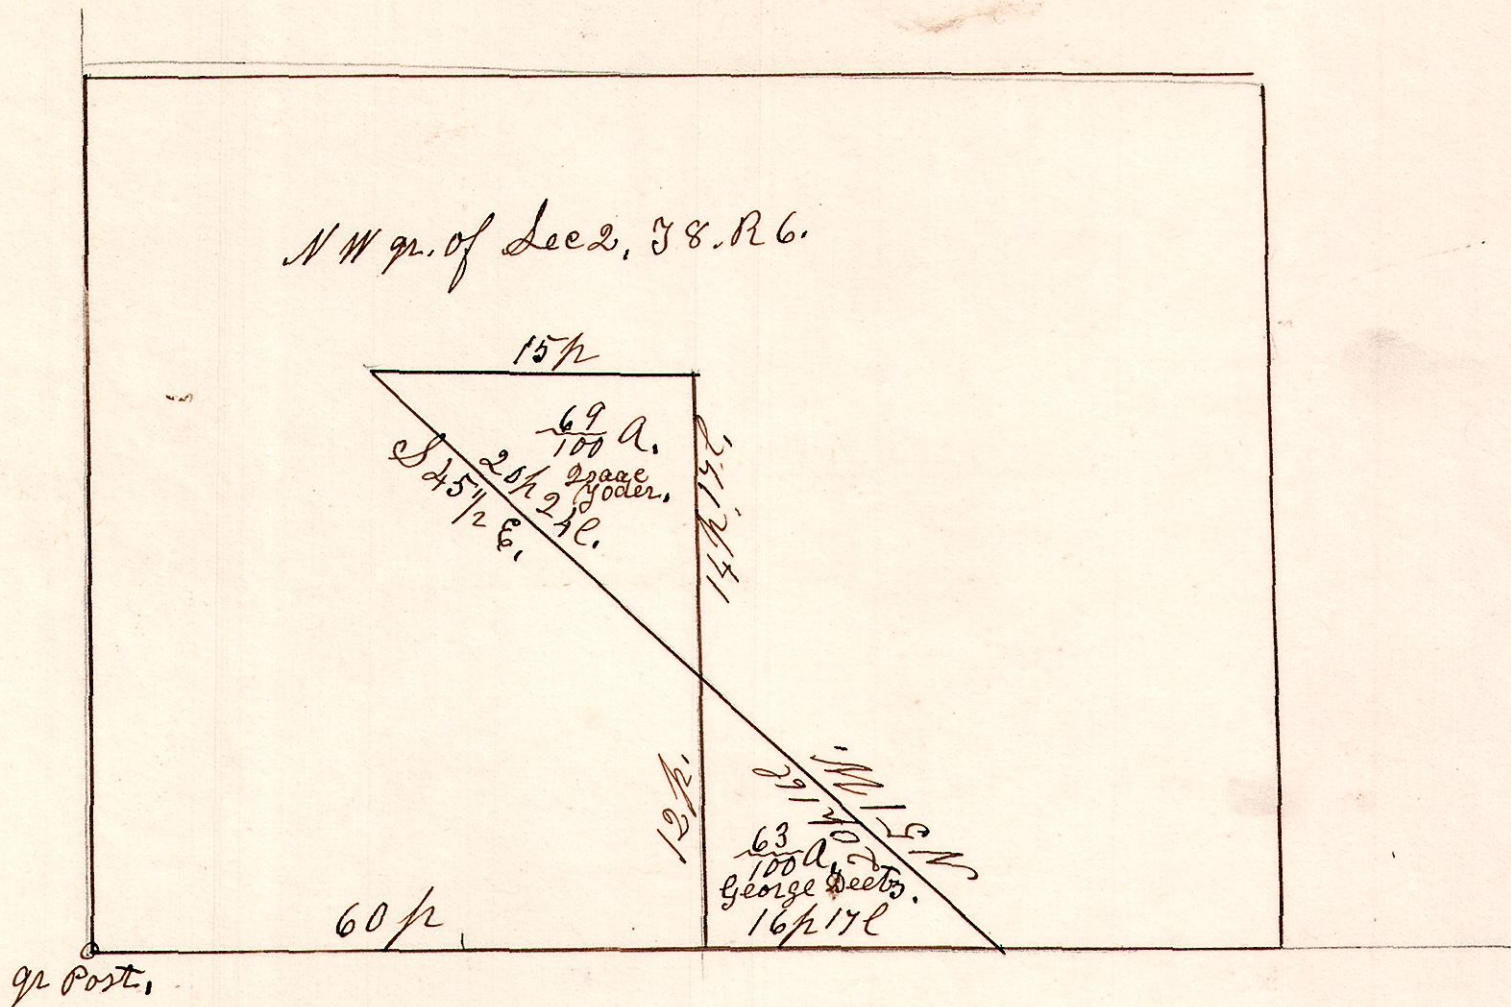

6-8-2

Oct 27th 1870.

Christian Neisly and Jacob Coblenz.

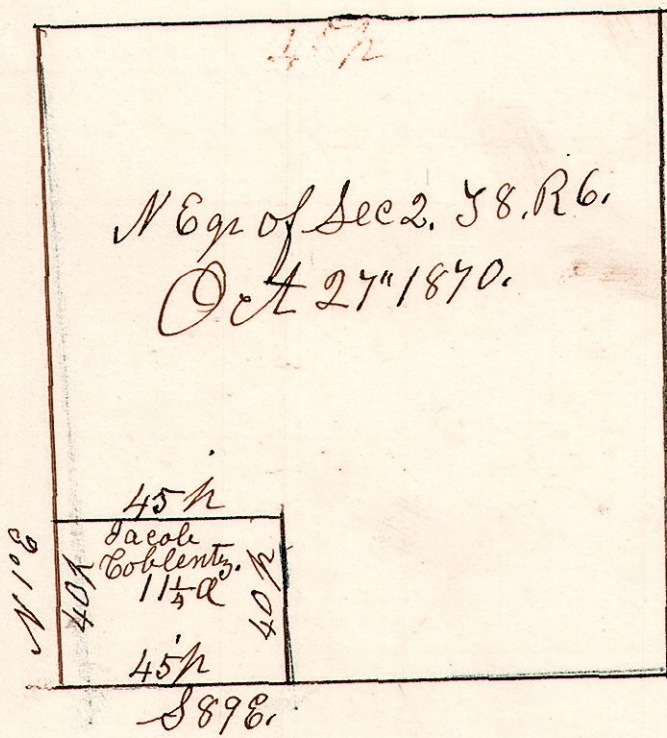

South west part of the north east quarter,
of Section No 2, in Township No 8, of Range No 6.