




6.9. 20. 1<sup>st</sup> gr. School Land.  
 March 29<sup>th</sup> 1867.

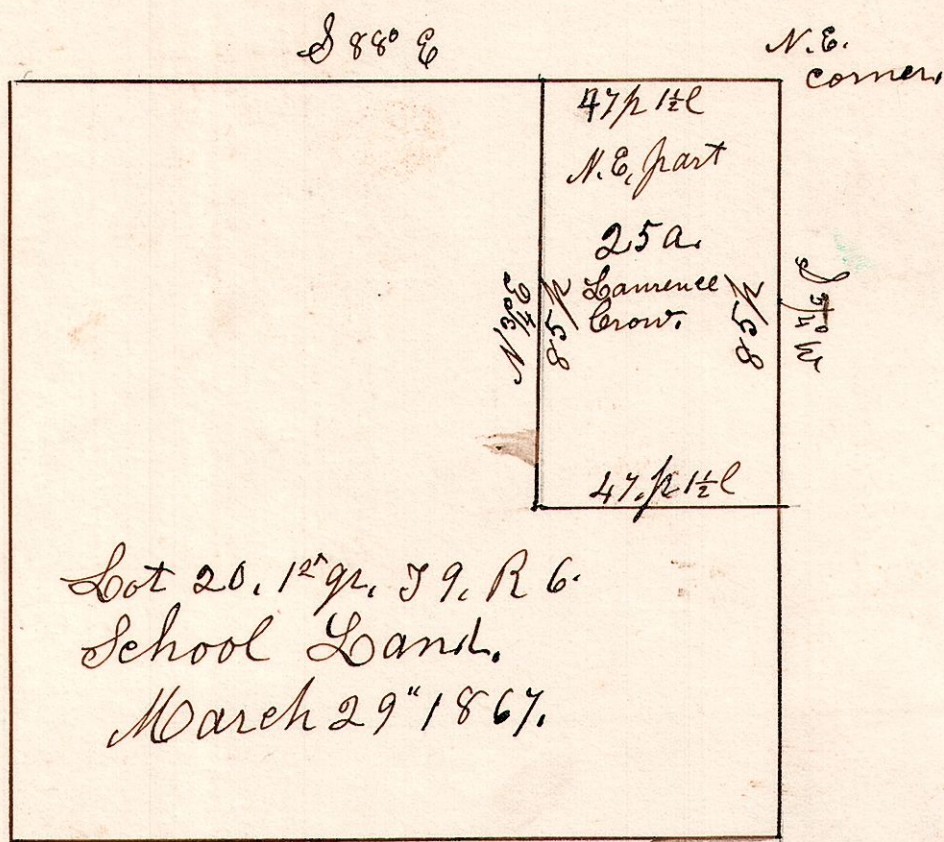

6.9. 21. 4<sup>th</sup> gr. School Land. April 10<sup>th</sup> 1846.

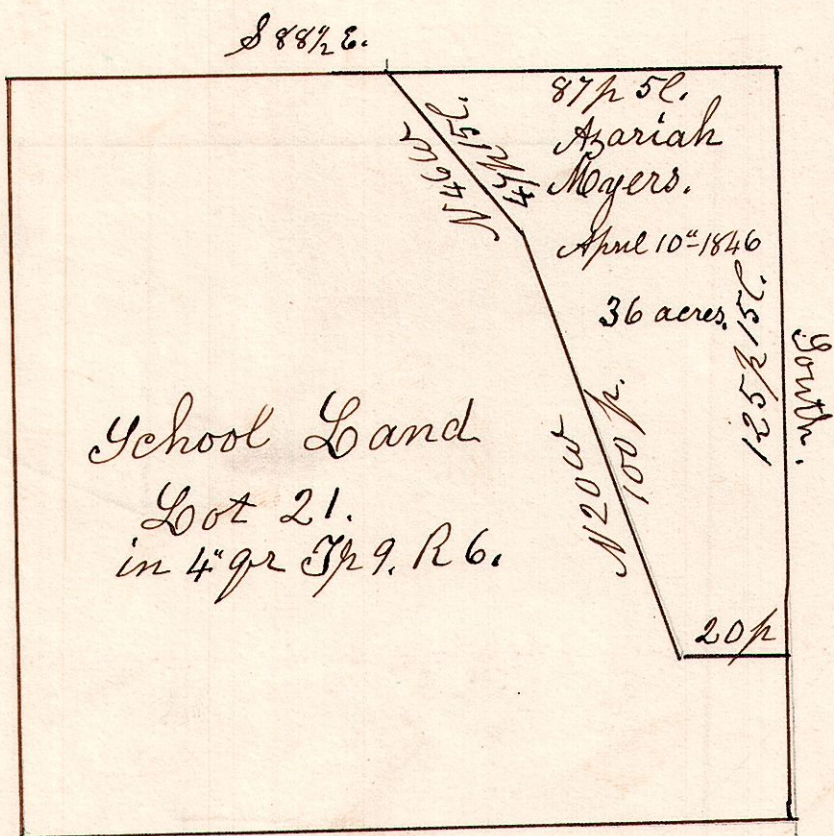

6.9. 6.9 1/2. Feb 21<sup>st</sup> 1857.

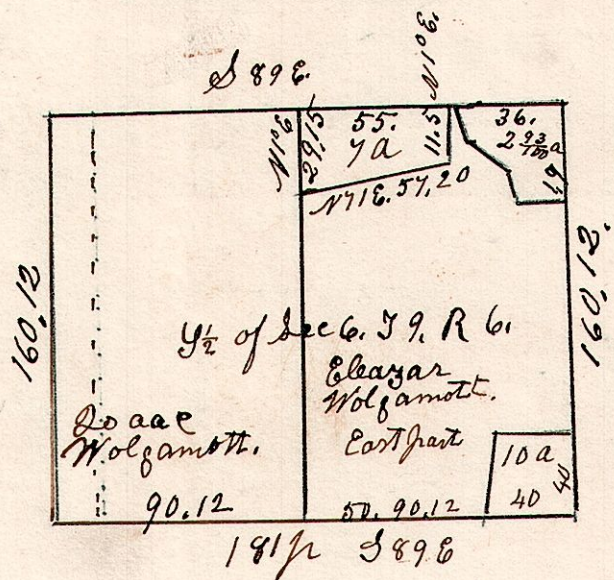

2 3/4 a. A Neff.  
 7 a Rufus Remington.  
 10 a S.E. pt George Rosta.  
 Feb 21<sup>st</sup> 1857.