


7.9. lot No. 1. of lot 8. 12th gr.

Lot No. 1. of Subdivision lot No. 8. in 12th gr. Tp 9. R 7 of the Connecticut Western Reserve School lands, Holmes Co. O.

Scale 10 chains to the inch.

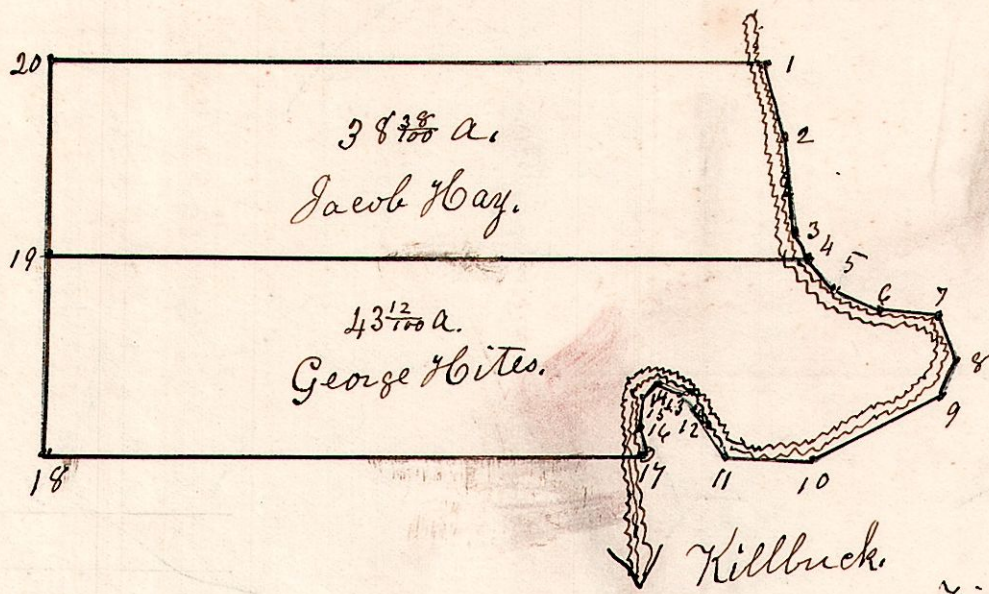

Field notes.

Point	Direction	Distance
4	S 45 1/4 E	2.50
5	S 66 E	1.50
6	S 84 E	3.50
7	S 25 E	2.30
8	S 20 W	1.70
9	S 61 W	7.53
10	West	4.90
11	N 22 1/2 W	3.00
12	N 42 3/4 W	1.00
13	N 69 1/2 W	1.90
14	S 52 W	.80
15	S 1/2 E	2.00
16	S 18 3/4 E	1.04
17	West	31.60
18	North	10.05
19	East	39.31 to place of beginning.

43 12/100 a.


Field notes.

Point	Direction	Distance
20	East	36.85
1	S 19 1/2 E	3.80
2	S 7 3/4 E	5.50
3	S 23 1/2 E	1.20
4	West	39.31
19	North	10.05 to place of beginning.

38 38/100 a.

5th lot show

7-8-8. October 17th 1858.

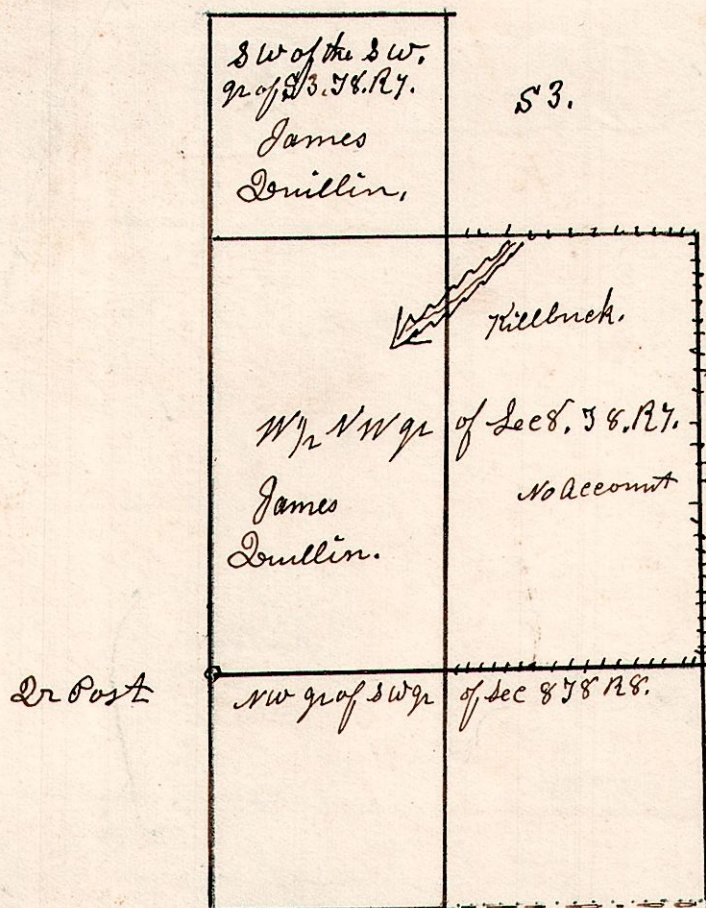

Oct 19th 1858.
SW of SW.