


5-9-21st 3rd gr

May 31st 1856.

162nd of foot

Surveyed May 31st 1856.

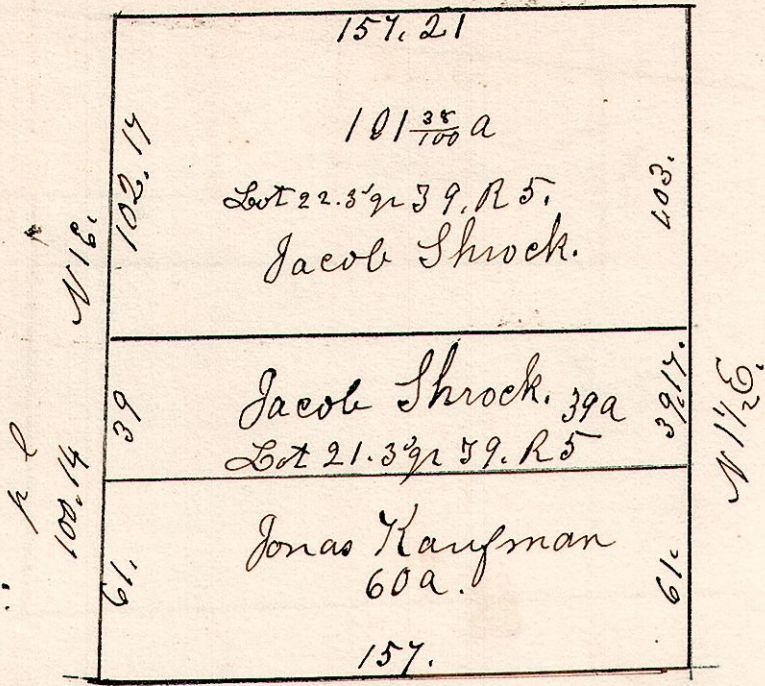

6-9-21st 1st gr.

May 31st 1856

N. Dak 36. S 66 W 15.
Hickory N 19 W 37

