L. 10. 38. 3° gr

951

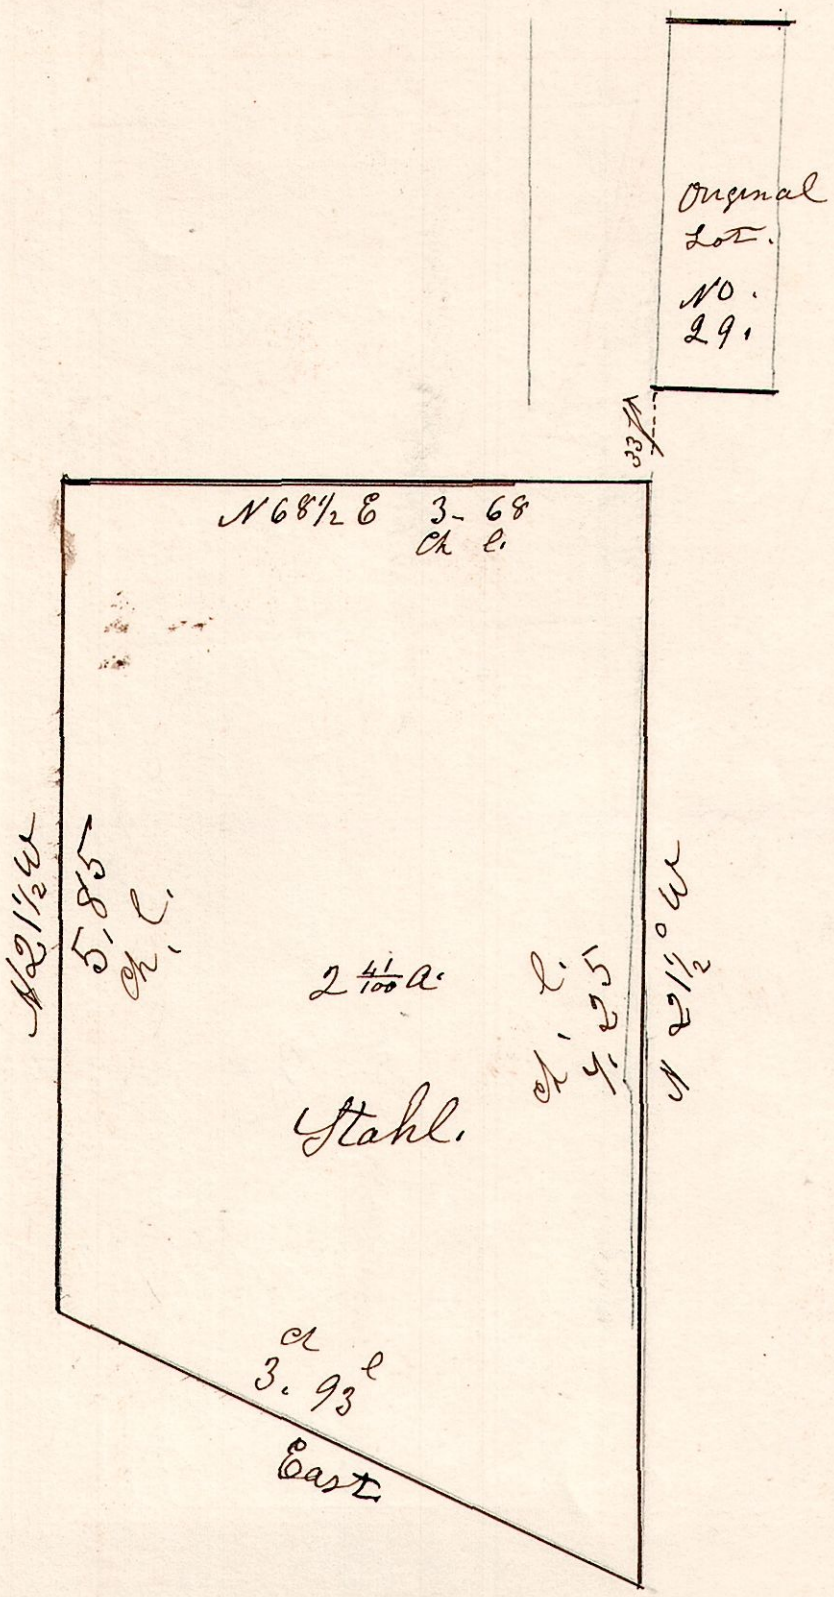

T. 9. R. 42. 1st Lot 42. 1st gr. Tp 9. R 7. E. W.R. School Land.
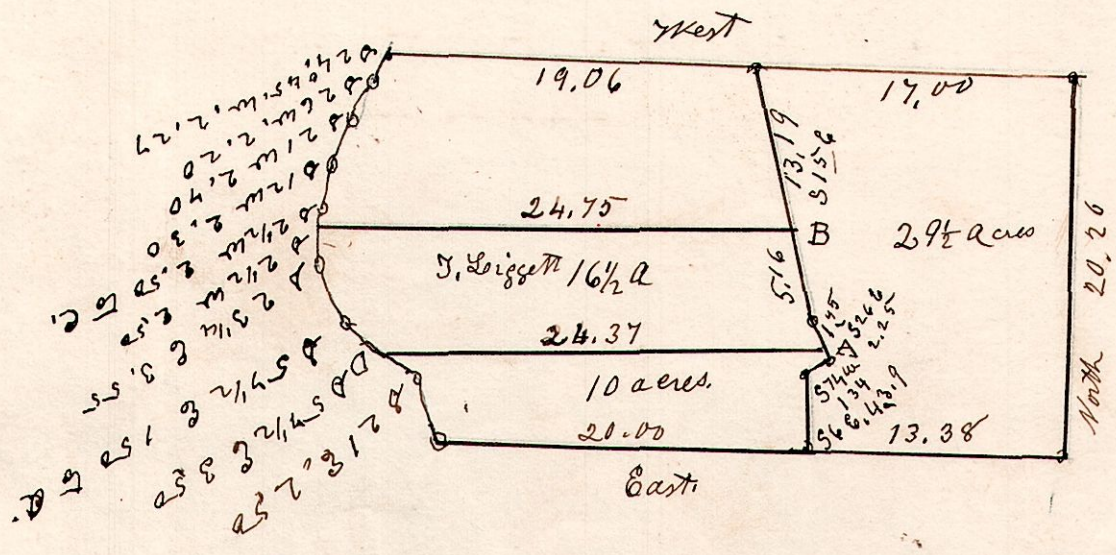
Surveyed for J. Liggett, 16½ acres.
December 24th 1840.