


7-9-19.


NE part of the NE q^r of Sec 19, T9, R7.
July 10th 1862.

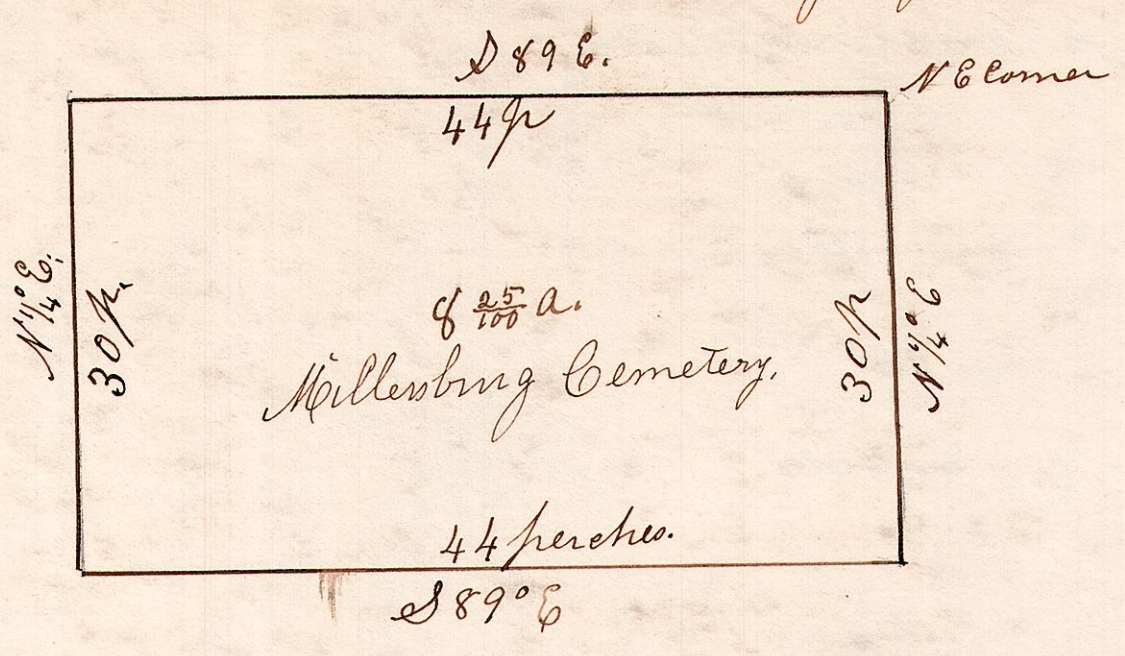

7-9-19. NE q^r

1871

956

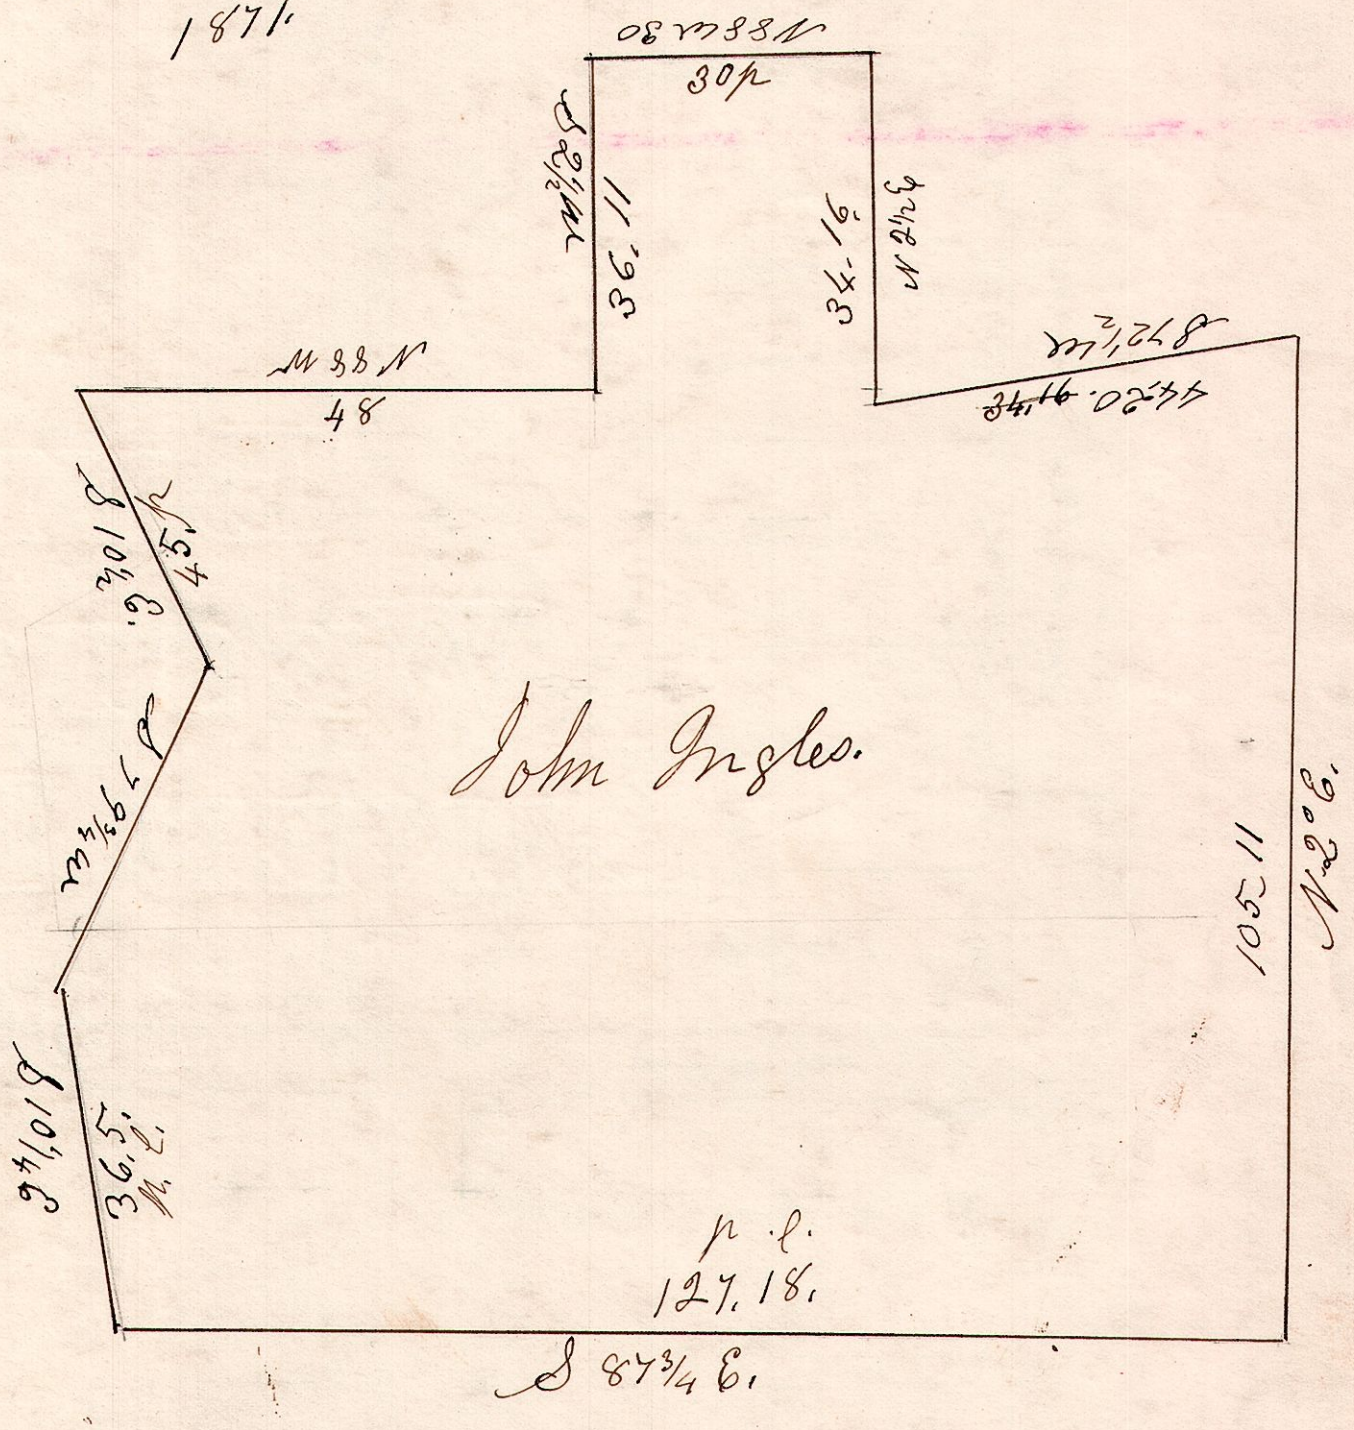

p. l.
127.18.