


6-8-11/12

Survey made for E.J. Varnes + Fred Baab to establish corner "C" and locate Line from C to D + C to E.  
Feb. 19, 1925.

H.L. Reidenbach  
Deputy Co. Surveyor

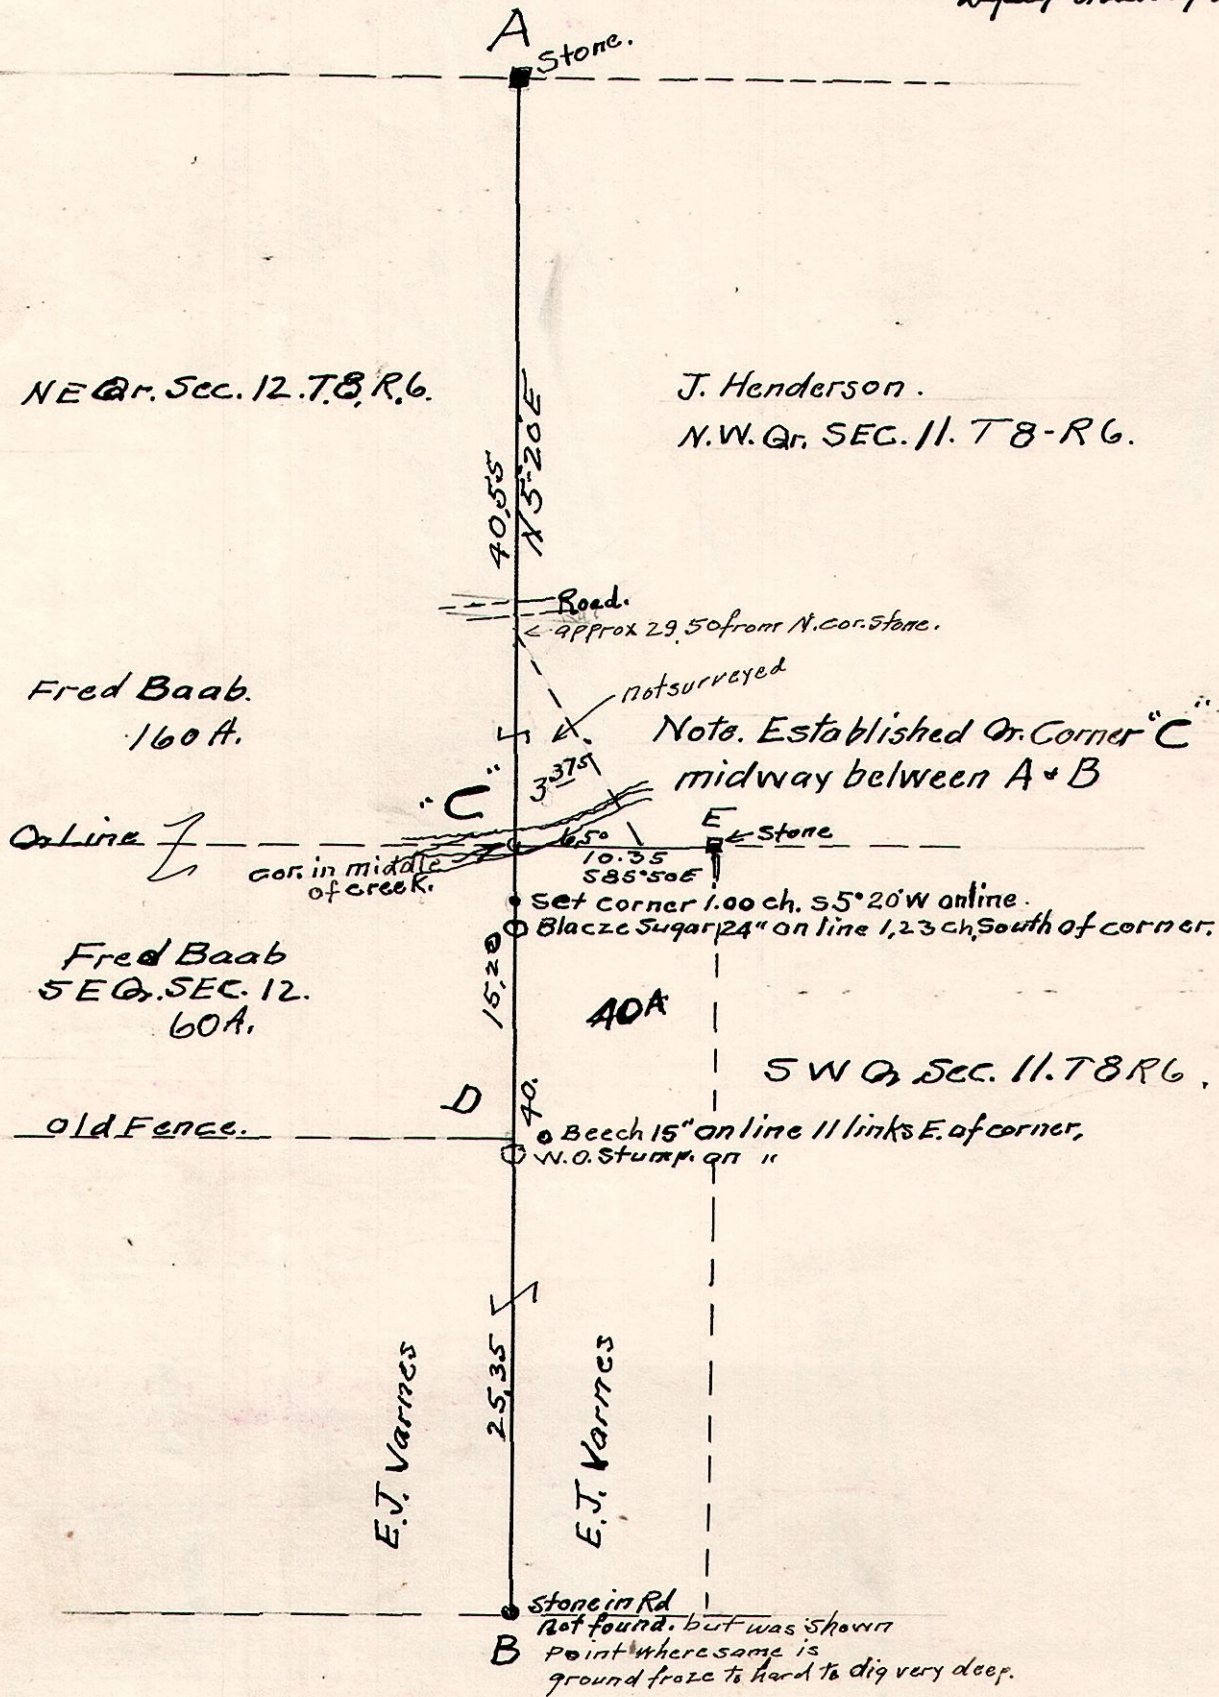

798  
30  
12) 23940 191  
12  
108  
14  
12  
20